

STATE WELL REPORT

Part 1

Driller's Log

Mississippi Department of Environmental Quality
Office of Land and Water Resources
P.O. Box 2309
Jackson, MS 39225-2309
(601)961-5210
(601)360-0535 (fax)

County: Jackson

Permit #: _____

Driller: Coast Water Well Serv

Date drilling completed: 8-16-13

For Office Use Only:

Well #: E198

Aquifer: _____

E-Log #: _____

State Law requires that this report be prepared by the license holder responsible for the work and filed with the Department at the above address within 30 days of completion of drilling of the well or borehole.

Well Owner Information (Landowner if borehole is not for a water well)	Well or Borehole Location
Owner Name: <u>Tyrone Olier</u>	Latitude: <u>30°34'9.54"</u> Longitude: <u>088°48'35.16"</u>
Mailing Address: <u>John Smith Road</u>	Method of Lat/Long (check one): Conventional Survey _____, USGS quad _____, Hand-held GPS <input checked="" type="checkbox"/> , Survey-grade GPS _____
<u>Vanceleave, ms 39565</u> City State Zip Code	<u>5/6</u> ^{NW} <u>1/4</u> <u>26</u> ^{NE} <u>1/4</u> , Sec. <u>32</u> <u>T. 55</u> <u>R. 8W</u>
Telephone No. <u>(228) 424-8479</u>	<u>7</u> Miles <u>WNW</u> of <u>Vanceleave</u> (Distance) (Direction) (Nearest Town)

Well / Borehole Data
Date drilling started: <u>8-14-13</u> Date drilling completed: <u>8-16-13</u> Hole depth: <u>537 FT</u> Hole diameter: <u>2</u>
Location of the source of any surface water used for drilling: <u>NO surface water used</u>
Method of dosing and volume of Chlorine used in drilling and development: <u>1 gal. per 1000 drilling - 2 gal in well</u>
Logs run (circle all applicable): <input checked="" type="checkbox"/> No log run <input type="checkbox"/> Electric <input type="checkbox"/> Gamma Ray <input type="checkbox"/> Density <input type="checkbox"/> Sonic <input type="checkbox"/> Neutron <input type="checkbox"/> Other: _____
Name of organization running log(s): _____
Purpose of borehole (circle one): <input checked="" type="checkbox"/> Water Well <input type="checkbox"/> Geotechnical/Geological Investigation <input type="checkbox"/> Ground Source Heat Pump <input type="checkbox"/> Seismic Survey <input type="checkbox"/> Other (describe) _____
<i>If drilling is not related to water well construction, skip the remainder of this block</i>
Purpose of Well (circle all applicable): <input checked="" type="checkbox"/> Home <input type="checkbox"/> Industrial <input type="checkbox"/> Public Supply <input type="checkbox"/> Irrigation <input type="checkbox"/> Fish Culture
Other (describe): _____
If a flowing well, method of flow regulation: Valve <u>N/A</u> Other (describe) _____
Static Water Level: <u>95</u> feet [above or <input checked="" type="checkbox"/> below] land surface Date measured: <u>8-16-13</u> (circle one)
Method of measurement (circle one): Steel tape <input type="checkbox"/> Electric tape <input type="checkbox"/> <input checked="" type="checkbox"/> Air line <input type="checkbox"/> Other (describe): _____
Well depth: <u>537 FT</u> Well grouted to a depth of: <u>10</u> feet Type of grout (circle one): Neat Cement <input type="checkbox"/> <input checked="" type="checkbox"/> Bentonite <input type="checkbox"/> Mix
Casing length: <u>522</u> feet Casing diameter: <u>2</u> inches Type of casing: <u>PVC</u>
Screen length: <u>15</u> feet Screen diameter: <u>2</u> inches Type of screen: <u>PVC</u>
Screen slot size: <u>1.000</u> inches Setting depth: From <u>522</u> feet to <u>537</u> feet
Type of completion (circle all applicable): Gravel packed <input type="checkbox"/> Underreamed <input type="checkbox"/> Open hole <input type="checkbox"/> <input checked="" type="checkbox"/> Natural Development
Other (describe): _____
Top of lap pipe or reduction in casing: <u>N/A</u> feet


If telescoped or more than one screen, describe on next page

Form: OLWR-SWR-1 (12/11) RECEIVED BY OLWR

County: Jackson
Permit #: _____

For Office Use Only:
Well #: E198

The sketch below only required for water wells
If well telescopes, show depths on sketch.

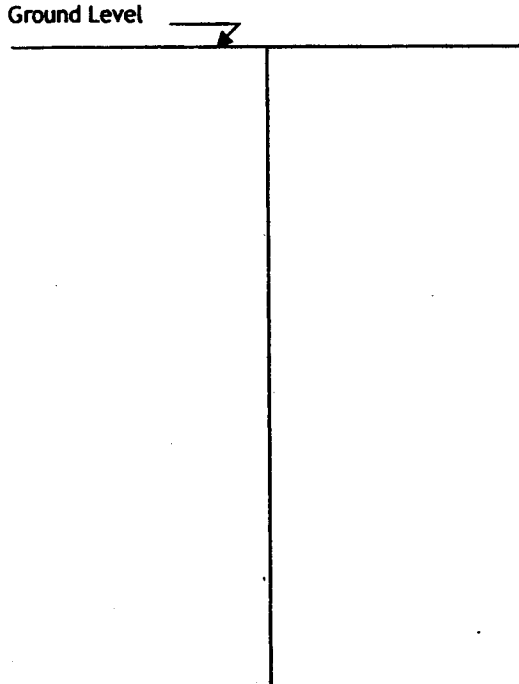


Description of formations encountered must be provided for all wells and boreholes, unless specifically exempted by regulations

Description of Formations Encountered	From (depth)	To (depth)
Top Soil	Ground level	2
Orange Clay	2	15
Orange Coarse Sand w/ clay	15	65
Orange Clay	65	105
Blue Clay	105	350
Gray medium Sand	350	381
Blue Clay	381	499
Gray Coarse sand	499	537

If more than one screen, show location of each on sketch

- Sketch the property layout and include the following:
- 1) the well location
 - 2) any permanent structures on the property that may aid in locating the well
 - 3) any roads, power lines, or other items that may aid in locating the property and the well
 - 4) north arrow

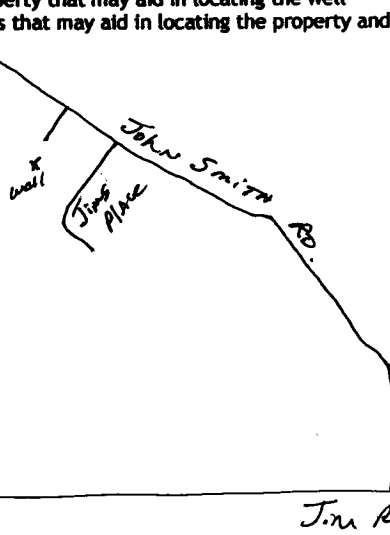

RECEIVED
AUG 22 2013
BY: OLWR

Landowner Name: Tyrone Olier

I HEREBY CERTIFY that the well/borehole was drilled, constructed, and completed in accordance with all applicable requirements of the Mississippi Department of Environmental Quality and the Mississippi Department of Health regulations, if applicable, and state laws.

JACK RIDGEMAN 0-472
Print Name of Responsible Licensee and License No.

8/20/13
Date

[Signature]
Signature of Licensee

STATE WELL REPORT

Part 2

Pump Installer's Completion Report
 Mississippi Department of Environmental Quality
 Office of Land and Water Resources
 P.O. Box 2309
 Jackson, MS 39225-2309
 (601)961-5210
 (601) 360-0535 (fax)

County: Jackson
 Permit #: _____
 Driller: 8-16-13
 Date completed: Coast Water Well
SRV.
 Copy information from block on Part 1

For Office Use Only:

Well #: E198
 Aquifer: _____

This part of the report must be completed by a licensed water well contractor or a licensed pump installer. A copy of Part 1 of the report must be attached and both parts filed with the Department at the above address within 30 days of well completion.

Well Owner Information	Well Location
Owner Name: <u>Tyrone Olier</u>	Latitude: <u>30°34'9.54"</u> Longitude: <u>088°48'35.16"</u>
Mailing Address: <u>John Smith Road</u>	Method of Lat/Long (check one): Conventional Survey _____, Hand-held GPS <input checked="" type="checkbox"/> , Survey-grade GPS _____
<u>Vanderveer, MS 39565</u>	USGS quad _____, Sec <u>32</u> T <u>5S</u> R <u>8W</u>
City _____ State _____ Zip Code _____	<u>7</u> Miles <u>WNW</u> of <u>Vanderveer</u>
Telephone No. <u>(601) 424-8479</u>	(Distance) _____ (Direction) _____ (Nearest Town) _____

Pump Type (circle one)

Submersible Turbine Air Lift Centrifugal Flowing Well Jet Piston Rotary Other (describe): _____

Date Pump Installed: 8-16-13 Rated Pump Capacity: 10 Gallons Per Minute

Is This Pump (circle one): New Repaired Replacement

Power Type (circle one)

Electric Diesel Gasoline Natural Gas Tractor PTO Windmill Other (describe): _____

Horse Power Rating of Motor: 2HP Setting Depth: 120' DP feet Number of Stages: 3

Pump Test Data for Non Flowing Well

Date Well Tested: 8-16-13 Duration of Pump Test (minimum 4 hours): 4 hours

Static Water Level (A): 95 Feet Below Land Surface Pumping Water Level (B): N/A Feet Below Land Surface

Drawdown [(B) - (A)]: N/A Feet Below Land Surface Test Pumping Rate: 10 Gallons Per Minute

Method of measurement (circle one): Steel tape Electric tape Air line Other (describe): _____

Pump Test Data for Flowing Well

Measured shut in head: _____ feet.

Well yielded _____ GPM with a drawdown of N/A feet after _____ hours of pumping

Meter Installation

Meter Manufacturer: _____ Meter Serial Number: _____

Meter Model Number/Name: _____ Type of Meter: _____

Totalizer Register Unit and Multiplier Factor (AF x .001, gal x 1000 etc): _____

Installation Date: _____ Meter installed by: [Signature]

Is This Meter (circle one): New Repaired Replacement

RECEIVED
 BY: OLWR

Important: By submitting the above information you are certifying that this meter was installed to manufacturer standards. For agricultural wells, a list of approved meters is on the MDEQ website.

I HEREBY CERTIFY that the above statements are true to the best of my knowledge.

Jack Ridgell 0-472 8/16/13 [Signature]
 Print Name of Pump Installer and License No. (if applicable) Date Signature of Pump Installer