

STATE WELL REPORT

Part 1

Driller's Log

Mississippi Department of Environmental Quality
 Office of Land and Water Resources
 P.O. Box 2309
 Jackson, MS 39225-2309
 (601)961-5210
 (601)360-0535 (fax)

For Office Use Only:

Well #: E237
 Aquifer: _____
 E-Log #: _____

County: Jackson
 Permit #: _____
 Driller: Coast Water Wells Svc.
 Date drilling completed: 9-17-18

State Law requires that this report be prepared by the license holder responsible for the work and filed with the Department at the above address within 30 days of completion of drilling of the well or borehole.

Well Owner Information <small>(Landowner if borehole is not for a water well)</small>	Well or Borehole Location
Owner Name: <u>Robert Stewart/Brandy Brown</u>	Latitude: <u>30°36'45.84"</u> Longitude: <u>D88°44'5.34"</u>
Mailing Address: <u>18938 Hwy 57</u>	Method of Lat/Long (check one): Conventional Survey _____
<u>Vanceleave, MS 39565</u>	USGS quad _____, Hand-held GPS <input checked="" type="checkbox"/> , Survey-grade GPS _____
City _____ State _____ Zip Code _____	<u>NW</u> ^{SE} <u>NE</u> ^{NE} <u>18</u> ¹³ <u>55</u> <u>R7w</u>
Telephone No. <u>(601) 238-7260</u>	<u>6</u> Miles <u>NW</u> of <u>Vanceleave</u>
	(Distance) (Direction) (Nearest Town)

Well / Borehole Data

Date drilling started: 9-14-18 Date drilling completed: 9-17-18 Hole depth: 773 FT Hole diameter: 2"

Location of the source of any surface water used for drilling: N/A

Method of dosing and volume of Chlorine used in drilling and development: 1 GAL Per 1000 Drilling 2 Gal in Well

Logs run (circle all applicable): No log run Electric Gamma Ray Density Sonic Neutron Other: _____

Name of organization running log(s): _____

Purpose of borehole (circle one): Water Well Geotechnical/Geological Investigation Ground Source Heat Pump

Seismic Survey Other (describe) _____

If drilling is not related to water well construction, skip the remainder of this block.

Purpose of Well (circle all applicable): Home Industrial Public Supply Irrigation Fish Culture

Other (describe): _____

If a flowing well, method of flow regulation: Valve _____ Other (describe) _____

Static Water Level: 110 feet [above or below] and surface Date measured: 9-17-18

Method of measurement (circle one): Steel tape Electric tape Air line Other (describe): _____

Well depth: 773 FT Well grouted to a depth of: 10 feet Type of grout (circle one): Neat Cement Bentonite Mix

Casing length: 758 feet Casing diameter: 2 inches Type of casing: PVC

Screen length: 15 feet Screen diameter: 2 inches Type of screen: PVC

Screen slot size: .004 inches Setting depth: From 758 feet to 773 feet

Type of completion (circle all applicable): Gravel packed Underreamed Open hole Natural Development

Other (describe): _____

Top of lap pipe or reduction in casing: N/A feet

If telescoped or more than one screen, describe on next page

RECEIVED
OCT 08 2018
BY OLWR

10/17/58

RECEIVED
OCT 17 1958

10/17/58

10/17/58

RECEIVED
OCT 17 1958

RECEIVED
OCT 17 1958

BY OLMR

RECEIVED
OCT 17 1958

RECEIVED
OCT 17 1958


RECEIVED
OCT 17 1958

County: Jackson
Permit #: _____

For Office Use Only:
Well #: E237

The sketch below only required for water wells
If well telescopes, show depths on sketch.

Description of formations encountered must be provided for all wells and boreholes, unless specifically exempted by regulations

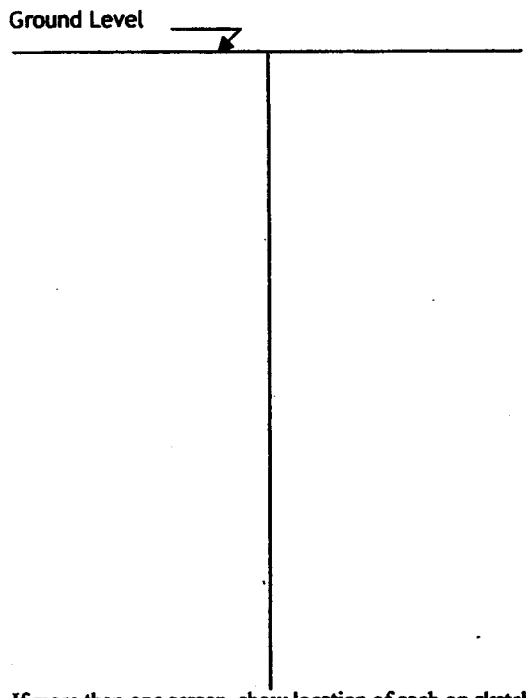


Description of Formations Encountered	From (depth)	To (depth)
Top Soil	Ground level	2
Orange Clay w/ streaks of sand	2	100
Blue Clay	100	753
Gray Medium Sand	753	773

If more than one screen, show location of each on sketch

Sketch the property layout and include the following:

- 1) the well location
- 2) any permanent structures on the property that may aid in locating the well
- 3) any roads, power lines, or other items that may aid in locating the property and the well
- 4) north arrow

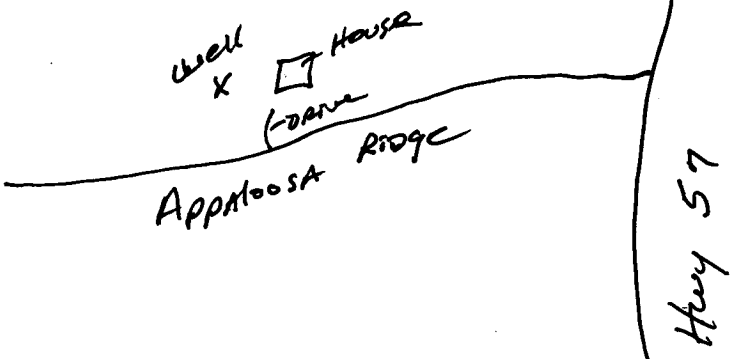

RECEIVED
OCT 08 2018
BY OLWR

Landowner Name: Brandy Brown / Robert Stewart

I HEREBY CERTIFY that the well/borehole was drilled, constructed, and completed in accordance with all applicable requirements of the Mississippi Department of Environmental Quality and the Mississippi Department of Health regulations, if applicable, and state laws.

Jack Ridgdell 0-472
Print Name of Responsible Licensee and License No.

9/19/18
Date

Jan Reddick
Signature of Licensee

RECEIVED
OCT 08 2006
BY OLWR

Handwritten text, possibly a signature or date, located at the bottom center of the page.

Handwritten text, possibly initials, located at the bottom of the page.

Multiple lines of very faint, mostly illegible text and markings, possibly bleed-through from the reverse side of the document.

Handwritten text in the upper right corner, possibly a date or reference number.

STATE WELL REPORT

Part 2

Pump Installer's Completion Report
 Mississippi Department of Environmental Quality
 Office of Land and Water Resources
 P.O. Box 2309
 Jackson, MS 39225-2309
 (601)961-5210
 (601) 360-0535 (fax)

County: Jackson
 Permit #: _____
 Driller: Eastwater Wells LLC
 Date completed: 9-17-18
Copy information from block on Part 1

For Office Use Only:

Well #: E237
 Aquifer: _____

This part of the report must be completed by a licensed water well contractor or a licensed pump installer. A copy of Part 1 of the report must be attached and both parts filed with the Department at the above address within 30 days of well completion.

Well Owner Information	Well Location
Owner Name: <u>Robert Stewart / Brandy Brown</u>	Latitude: <u>33° 36' 45.84"</u> Longitude: <u>088° 44' 5.34"</u>
Mailing Address: <u>18938 Hwy 57</u>	Method of Lat/Long (check one): Conventional Survey _____, USGS quad _____, Hand-held GPS <input checked="" type="checkbox"/> , Survey-grade GPS _____
<u>Vanceleave, MS 39565</u>	<u>NW 1/4 NE 1/4, Sec 18 T 5 S R 20 W</u>
City: _____ State: _____ Zip Code: _____	<u>6</u> Miles <u>NW</u> of <u>Vanceleave</u>
Telephone No. <u>(228) 238-7260</u>	(Distance) (Direction) (Nearest Town)

Pump Type (circle one)

Submersible Turbine Air Lift Centrifugal Flowing Well Jet Piston Rotary Other (describe): _____

Date Pump Installed: 9-18-18 Rated Pump Capacity: 7.5 Gallons Per Minute

Is This Pump (circle one): New Repaired Replacement

Power Type (circle one)

Electric Diesel Gasoline Natural Gas Tractor PTO Windmill Other (describe): _____

Horse Power Rating of Motor: 2HP Setting Depth: 140FT DP feet Number of Stages: 3

Pump Test Data for Non Flowing Well

Date Well Tested: 9-18-18 Duration of Pump Test (minimum 4 hours): 5 hours

Static Water Level (A): 110 Feet Below Land Surface Pumping Water Level (B): N/A Feet Below Land Surface

Drawdown [(B) - (A)]: N/A Feet Below Land Surface Test Pumping Rate: 7.5 Gallons Per Minute

Method of measurement (circle one): Steel tape Electric tape Air line Other (describe): _____

Pump Test Data for Flowing Well

Measured shut in head: _____ feet.

Well yielded _____ GPM with a drawdown of N/A feet after _____ hours of pumping

Meter Installation

Meter Manufacturer: _____ Meter Serial Number: _____

Meter Model Number/Name: _____ Type of Meter: _____

Totalizer Register Unit and Multiplier Factor (AF x .001, gal x 1000, etc): _____

Installation Date: _____ Meter installed by: _____

Is This Meter (circle one): New Repaired Replacement

Important: By submitting the above information you are certifying that this meter was installed to manufacturer standards. For agricultural wells, a list of approved meters is on the MDEQ website.

RECEIVED
OCT 08 2018
BY OLWR

I HEREBY CERTIFY that the above statements are true to the best of my knowledge.

Jack Ridgell 0-472 9/19/18 _____
 Print Name of Pump Installer and License No. (if applicable) Date Signature of Pump Installer

RECEIVED
OCT 28 2008
BY OLWIR

OLWIR