

JACKSON
E 2003
4-11-77

MISSISSIPPI
BOARD OF WATER COMMISSIONERS
416 North State Street
132 Jackson, Mississippi 39201

WATER WELL DRILLERS LOG

April 11th 1977 Cont Water Well Sew. Jackson
date well completed firm name county well located

LANDOWNER: Ray Bowen

description of formations encountered

1008 Royal Road
Gautier, Miss. 39033
(mailing address)

from	to
0	15
15	35
35	45
45	90
90	268
268	349
349	560
560	570
570	754
754	818

WELL LOCATION:
sec. 27 T. 5 N. R. 8 W. S. 14
7 miles N.W. of Hancock
(distance) (direction) (nearest town)

WELL PURPOSE:
(home, irrigation, municipal, industrial)

WELL COMPLETION DATA:
(1) diameter (inches) 2"
(2) total depth (feet) 818
(3) static water level (feet) 45 below above top of ground.
(4) casing PVC 8.08 (material) (depth)
- 2' If telescope see back. (size)
(5) screen 10' 8.08 (length) (depth to top)
2" PVC (size) (material)
(6) pump 1-hp 8 (HP) (yield gpm)
Eli's (type power)
(7) electric log (yes or no)

Top soil
fine sand
Red Clay
Med. sand
Blue Clay
Coarse sand
blue clay
~~Shale~~
Shale
blue clay
Med to Coarse sand

(organization running log)
(8) how well bottom plugged Jackson Value

RECEIVED


SEP 21 1977

DRILLERS REMARKS:

MISS. BO. OF WATER COMMISSIONERS

If well telescopes please sketch and show depths.

GROUND LEVEL

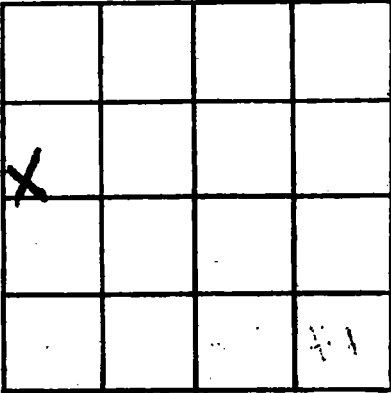

SECTION *44*

Please indicate well location X.

ADDITIONAL INFORMATION

If more than one screen, show locations of each on sketch.