

**MISSISSIPPI  
BOARD OF WATER COMMISSIONERS**  
416 North State Street  
Jackson, Mississippi 39201

**WATER WELL DRILLERS LOG**

**JACKSON**  
**E 2084**  
**5/4/77**

132

May 4 1977  
date well completed

Diuff - Well Co  
firm name

Jackson  
county well located

LANDOWNER: Ronnie Diuff

description of formations encountered

from to

RT 4

Ocean Springs  
(mailing address)

red clay

0 18'

fine white sand

18' 25'

**WELL LOCATION:**

sec. 26 T 5 N R 8 E  
10 4<sup>+</sup> miles North W of Madison  
(distance) (direction) (nearest town)

yellow clay

20' 55'

Blue Clay

55' 220'

**WELL PURPOSE:** None  
(home, irrigation, municipal, industrial)

fine Blue sand

220 290

**WELL COMPLETION DATA:**

- (1) diameter (inches) 2 1/2
- (2) total depth (feet) 290
- (3) static water level (feet) 123 <sup>below</sup> above top of ground.
- (4) casing Pvc, 282'  
(material) (depth)  
         if telescope see back.  
(size)
- (5) screen 8', 282'  
(length) (depth to top)  
2", Pvc  
(size) (material)
- (6) pump 1 1/2 5  
(HP) (yield gpm)  
ola  
(type power)
- (7) electric log no  
(yes or no)  
          
(organization running log)
- (8) how well bottom plugged B W V


**RECEIVED**  
JUL 11 1977

MISS. BD. OF WATER COMMISSIONERS

DRILLERS REMARKS:

If well telescopes please sketch and show depths.

GROUND LEVEL

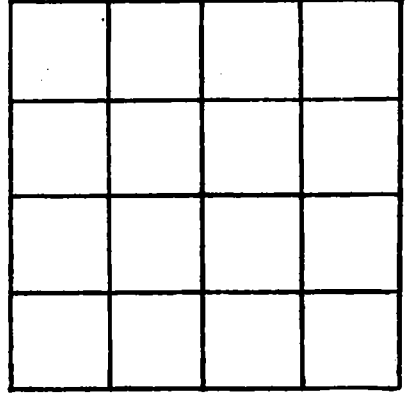

SECTION \_\_\_\_\_

Please indicate well location X.

ADDITIONAL INFORMATION

If more than one screen, show locations of each on sketch.