

Jackson  
 E 2007  
 5/22/77

MISSISSIPPI  
 BOARD OF WATER COMMISSIONERS  
 416 North State Street  
 132 Jackson, Mississippi 39201

WATER WELL DRILLERS LOG

5/22/77 date well completed  
 Coastal Drilling firm name  
 Jackson county well located

LANDOWNER: Bernie E. Scarborough  
Rt 6 Biloxi, Miss  
 (mailing address)

description of formations encountered	from	to
top soil	1	3
red clay	3	25
soft blue clay	25	230
fine water sand	230	260
soft blue clay	260	300
hard blue clay	300	540
fine water sand	540	600
hard blue clay	600	780
fine rock	780	795
hard blue clay	795	810
fine water sand	810	825
course water sand	825	865

WELL LOCATION:  
 sec. 5 T. 5 S. R. 9 E.  
 (2) 1/2 miles (distance) S (direction) Home, Miss (nearest town)

WELL PURPOSE: home  
 (home, irrigation, municipal, industrial)

WELL COMPLETION DATA:  
 (1) diameter (inches) 2"  
 (2) total depth (feet) 865'  
 (3) static water level (feet) 46 below above top of ground  
 (4) casing PVC 855'  
(material) (depth)  
 \_\_\_\_\_ If telescope see back.  
(size)  
 (5) screen 10' 855'  
(length) (depth to top)  
2" PVC  
(size) (material)  
 (6) pump 1/2 10  
(HP) (yield gpm)  
Ele  
(type power)  
 (7) electric log no  
(yes or no)  
 \_\_\_\_\_  
(organization running log)  
 (8) how well bottom plugged \_\_\_\_\_

RECEIVED


NOV 28 1977

DRILLERS REMARKS:  
2" back water valve

MISS. BD. OF WATER COMM.

If well telescopes please sketch and show depths.

GROUND LEVEL

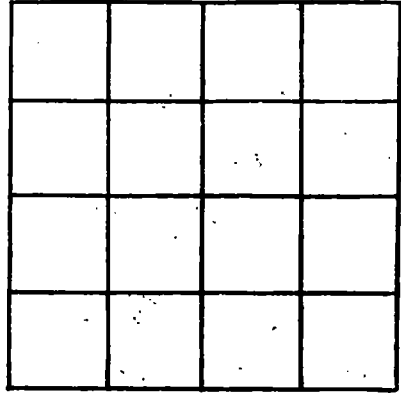

SECTION \_\_\_\_\_

Please indicate well location X.

ADDITIONAL INFORMATION

If more than one screen, show locations of each on sketch.