

MISSISSIPPI DEPARTMENT OF NATURAL RESOURCES
Bureau of Land and Water Resources

P.O. Box 10631
Jackson, Mississippi 39209
WATER WELL DRILLERS LOG

COUNTY WELL LOCATED <i>Jackson</i>	
WELL NUMBER <i>E 7014</i>	CODED
DATE WELL COMPLETED <i>7/7/89</i>	

PERMIT NUMBER
NAME OF DRILLING FIRM <i>Pierce Drilling Co.</i>

NAME & MAILING ADDRESS OF LANDOWNER <i>Lewis Sigmon</i>		
<i>O'Neal Rd.</i>		
<i>Voncleave, Ms</i>		
WELL LOCATION: SEC	TOWNSHIP	RANGE
<i>4</i>	<i>5</i>	<i>8</i>
DISTANCE	DIRECTION	NEAREST TOWN
<i>5</i> Miles	<i>West</i>	<i>Stone Mountain</i>
OTHER LANDMARK		
WELL PURPOSE: <input checked="" type="checkbox"/> Home Irrigation, <input type="checkbox"/> Municipal, <input type="checkbox"/> Industrial, <input type="checkbox"/> Fish Pond, etc.		

PUMP DATA		
PUMP TYPE (Circle One): Submersible, Turbine, <input checked="" type="radio"/> Jet, Flowing Well, Other (Describe) _____		
POWER TYPE (Circle One): <input checked="" type="radio"/> Electric, Tractor, Diesel, Gasoline, Butane, Other (Describe) _____		
Pump Capacity (GPM)	No. of Stages	Setting Depth
<i>8</i>	<i>2</i>	<i>70</i> FT.
PUMP TEST		
Well yielded <i>8</i> GPM with a drawdown of <i>10</i> ft. after <i>1</i> hours of pumping		

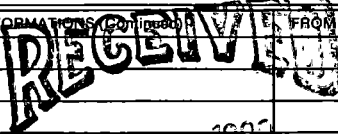
WELL DATA		
Well Depth <i>240</i>	Casing Diameter (In.) <i>2</i>	Casing Length (Ft.) <i>230</i>
Type of Casing <i>Plastic</i>	Hole Depth <i>240</i>	Depth to Static Water Level <i>70'</i>
TYPE OF COMPLETION: (Circle One or More): <input checked="" type="checkbox"/> Gravel Packed, <input type="checkbox"/> Underreamed, <input type="checkbox"/> Telescoped, <input checked="" type="checkbox"/> Natural Development, <input type="checkbox"/> Open Hole, <input type="checkbox"/> Other (Describe) _____		
Top of Lap Pipe or Reduction in Casing		
FEET		
IF TELESCOPED OR MORE THAN ONE SCREEN: USE BACK PAGE		

LOG DATA	
TYPE OF LOG RUN (Circle One): Electric, Gamma Ray, Density, Sonic, Neutron, Other (Describe) _____	
<input checked="" type="radio"/> No Log Run	
Name of Organization Running Log	

SCREEN DATA		
Diameter - Inches <i>2"</i>	Length - Feet <i>10'</i>	Slot Size - Inches <i>006</i>
Screen Type <i>Plastic</i>	Depth to Bottom - Feet <i>240</i>	

GEOLOGIC DATA (Office Use Only)			
Surface Elev.	Geologic Unit	Unit Thickness	Depth to Top
Subs. SWL	Date	Analysis	Aquifer Test

Driller's Remarks

DESCRIPTION OF FORMATIONS ENCOUNTERED	FROM	TO	FORMATIONS (continued)	FROM	TO
<i>Top soil</i>	<i>0</i>	<i>10</i>	 OCT 24 1989 Department of Natural Resources Bureau of Land & Water Resources		
<i>Clay</i>	<i>10</i>	<i>18</i>			
<i>Good Sand</i>	<i>18</i>	<i>30</i>			
<i>Clay</i>	<i>30</i>	<i>220</i>			
<i>Good Sand</i>	<i>220</i>	<i>240</i>			

IF MORE SPACE IS NEEDED, USE BACK

If well telescopes please sketch and show depths.

GROUND LEVEL

SECTION _____

Please indicate well location X.

ADDITIONAL INFORMATION

If more than one screen,
show location of each on sketch.