

JACKSON
E 2015
5-5-80

MISSISSIPPI
BOARD OF WATER COMMISSIONERS
416 North State Street
Jackson, Mississippi 39201

WATER WELL DRILLERS LOG

5-5-80 1980 *Duncan Well Drilling* *Jackson*
date well completed firm name county well located

LANDOWNER: *Randy Smith*
P.O. Box 575-A North
Biloxi, Ms.
(mailing address)

description of formations encountered	from	to
<i>Clay</i>	<i>0</i>	<i>25</i>
<i>sand</i>	<i>25</i>	<i>40</i>
<i>Blue Clay</i>	<i>40</i>	<i>380</i>
<i>sandy clay</i>	<i>380</i>	<i>420</i>
<i>Blue Clay</i>	<i>420</i>	<i>750</i>
<i>fine sand</i>	<i>750</i>	<i>783</i>
<i>Course Sand</i>	<i>783</i>	<i>798</i>

WELL LOCATION:
sec. 7 T. 5 N. R. 8 E
20 miles N. of Ocean Springs
(distance) (direction) (nearest town)

WELL PURPOSE: *Home*
(home, irrigation, municipal, industrial)

WELL COMPLETION DATA:
(1) diameter (inches) *7984*
(2) total depth (feet) *72'*
(3) static water level (feet) *90'* *below* above top of ground.
(4) casing *PVC*, *798'*
(material) (depth)
If telescope see back.
(size)
(5) screen *10'*, *788'*
(length) (depth to top)
2", *PVC*
(size) (material)
(6) pump *2*, *6*
(HP) (yield gpm)
electric
(type power)
(7) electric log *---*
(yes or no)

(organization running log)
(8) how well bottom plugged *Sand*
Shut

DRILLERS REMARKS:


DEPT. OF NATURAL RESOURCES
BUREAU OF LAND & WATER RESOURCES

SEP 22 1980

RECEIVED

If well telescopes please sketch and show depths.

GROUND LEVEL

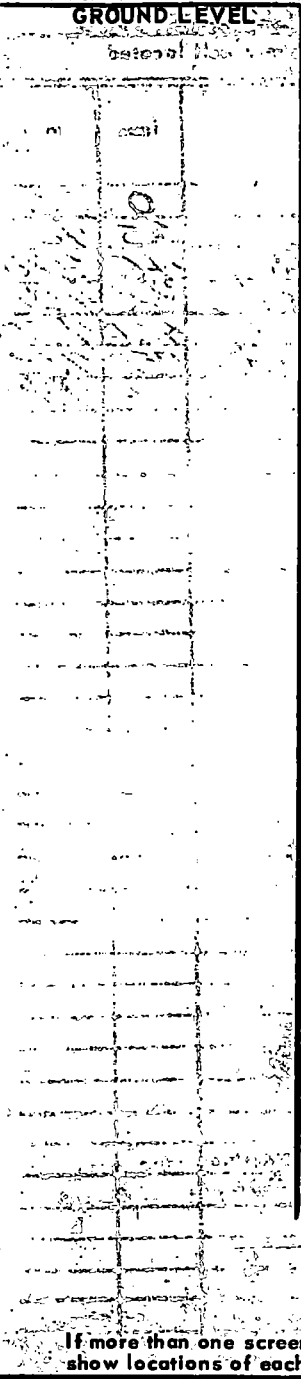

If more than one screen, show locations of each on sketch.

A 4x4 grid with a handwritten 'X' in the top-right cell and a handwritten '7' in the bottom-right cell.

SECTION _____

Please indicate well location X.

ADDITIONAL INFORMATION

Multiple horizontal lines for providing additional information.