

MISSISSIPPI DEPARTMENT OF NATURAL RESOURCES

Bureau of Land and Water Resources

Southport Mall

P.O. Box 10631

Jackson, Mississippi 39209

WATER WELL DRILLERS LOG

Jackson
E 2018
5-12-81

May 12 1981 Duncan Well Drilling Jackson
date well completed firm name county well located

LANDOWNER: Robert Montgomery
14181 Jimmy Raymond Rd. Rt. 1.
Ocean Springs, Ms.
(mailing address)

description of formations encountered	from	to
Clay	0	20
Sand	20	35
Blue Clay	35	208
Green Sand	208	219
Blue Clay	219	423
Green Sand	423	460
Course Sand	460	483

WELL LOCATION:
sec. 30 T. 5 N. R. 9E
4 miles S.E. of Farne
(distance) (direction) (nearest town)

WELL PURPOSE: home
(home, irrigation, municipal, industrial)

WELL COMPLETION DATA:

- (1) diameter (inches) 2"
- (2) total depth (feet) 483 ft.
- (3) static water level (feet) 15' below top of ground.
- (4) casing PVC, 483'
(material) (depth)
- (size) if telescope see back.
- (5) screen 10', 473'
(length) (depth to top)
- (size) 2", PVC
(size) (material)
- (6) pump 1 12
(HP) (yield gpm)
- electric
(type power)
- (7) electric log —
(yes or no)
- (organization running log)
- (8) how well bottom plugged Sand
Shank


DRILLERS REMARKS:

DEPT. OF NATURAL RESOURCES
BUREAU OF LAND & WATER RESOURCES

OCT 19 1981
RECEIVED

If well telescopes please sketch and show depths.

GROUND LEVEL

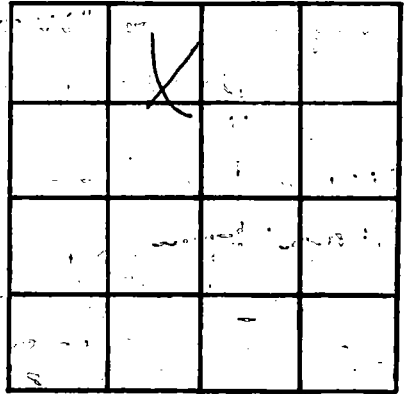

SECTION 30

Please indicate well location X.

ADDITIONAL INFORMATION

If more than one screen, show locations of each on sketch.