

MISSISSIPPI DEPARTMENT OF NATURAL RESOURCES
Bureau of Land and Water Resources
 Southport Mall
 P.O. Box 10631
 Jackson, Mississippi 39209
WATER WELL DRILLERS LOG

Jackson
E 7001

2-22-1982 19 Coast Water Well Sew. Jackson
 date well completed firm name county well located

LANDOWNER William Powell
Rt 11 - Box 98
Ocean Springs, Miss.
 (mailing address) 39564

description of formations encountered	from	to
<u>Top soil</u>	<u>0'</u>	<u>1'</u>
<u>Red Clay</u>	<u>1'</u>	<u>10'</u>
<u>Purple Clay</u>	<u>10'</u>	<u>30'</u>
<u>Grey Clay</u>	<u>30'</u>	<u>38'</u>
<u>White Clay</u>	<u>38'</u>	<u>50'</u>
<u>Blue Clay & Shale</u>	<u>50'</u>	<u>80'</u>
<u>Red sand</u>	<u>80'</u>	<u>126'</u>
<u>Red coarse sand & gravel</u>		

WELL LOCATION:
 sec. 12 T. 5 R. 9
1N miles of LARUE
 (distance) (direction) (nearest town)

WELL PURPOSE: Home
 (home, irrigation, municipal, industrial)

- WELL COMPLETION DATA:
- (1) diameter (inches) 2"
 - (2) total depth (feet) 126'
 - (3) static water level (feet) 55' below top of ground
 - (4) casing PVC, 116'
 (material) (depth)
2"
 (size) If telescope see back.
 - (5) screen 10', 116'
 (length) (depth to top)
2", PVC
 (size) (material)
 - (6) pump 1 hp., 7
 (HP) (yield gpm)
Elect
 (type power)
 - (7) electric log No
 (yes or no)
- (organization running log)

(8) how well bottom plugged Back wash valve

DRILLERS REMARKS:


DEPT. OF NATURAL RESOURCES
 BUREAU OF LAND & WATER RESOURCES

MAR 11 1982

RECEIVED

If well telescopes please sketch and show depths.

GROUND LEVEL

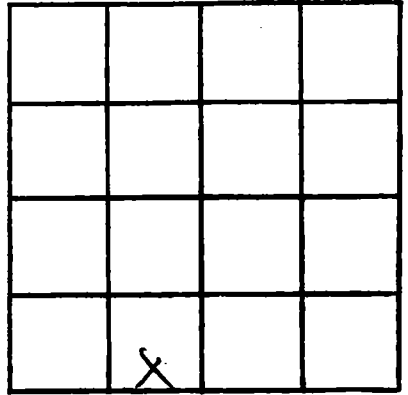

SECTION 12

Please indicate well location X.

ADDITIONAL INFORMATION

If more than one screen, show locations of each on sketch.