

MISSISSIPPI DEPARTMENT OF NATURAL RESOURCES

Bureau of Land and Water Resources

Southport Mall

P.O. Box 10631

Jackson, Mississippi 39209

WATER WELL DRILLERS LOG

Jackson
E 2022

9-6-82, 19 Coast Water Well Sew. Jackson
date well completed firm name county well located

LANDOWNER: Virgil Harper
Ph-1-Box 117F
Ocean Springs, Ms.
(mailing address) 3026

WELL LOCATION:
sec. 2 T. 5 S. R. 8 E.
8 miles NW of VAN CLEAVE
(distance) (direction) (nearest town)

WELL PURPOSE: Home
(home, irrigation, municipal, industrial)

WELL COMPLETION DATA:
(1) diameter (inches) 2"
(2) total depth (feet) 196'
(3) static water level (feet) 100' ^{below}/_{above} top of ground.
(4) casing PVC, 186'
(material) (depth)
2" If telescope see back.
(size)
(5) screen 10', 186'
(length) (depth to top)
2", PVC
(size) (material)
(6) pump 2hp, 5 1/2
(HP) (yield gpm)
Check.
(type power)
(7) electric log No.
(yes or no)
—
(organization running log)
(8) how well bottom plugged
back wash valve

description of formations encountered	from	to
<u>Top soil</u>	<u>0</u>	<u>3'</u>
<u>Red Clay</u>	<u>3'</u>	<u>15'</u>
<u>Purple Clay</u>	<u>15'</u>	<u>25'</u>
<u>White Clay & streak of sand</u>	<u>25'</u>	<u>80'</u>
<u>Blue Clay</u>	<u>80'</u>	<u>101'</u>
<u>Blue fine sand</u>	<u>101'</u>	<u>115'</u>
<u>Blue Clay</u>	<u>115'</u>	<u>180'</u>
<u>Gray coarse sand</u>	<u>180'</u>	<u>196'</u>

DEPT. OF NATURAL RESOURCES
BUREAU OF LAND & WATER RESOURCES


NOV 18 1982

RECEIVED

DRILLERS REMARKS:

If well telescopes please sketch and show depths.

GROUND LEVEL

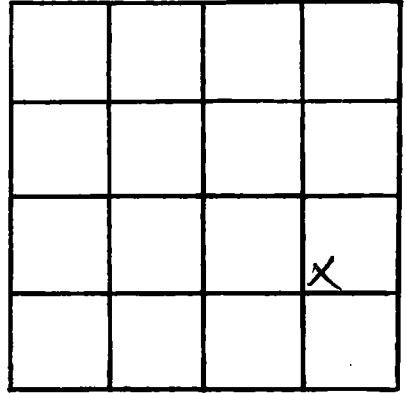

SECTION 2

Please indicate well location X.

ADDITIONAL INFORMATION

If more than one screen, show locations of each on sketch.