

MISSISSIPPI DEPARTMENT OF NATURAL RESOURCES

Bureau of Land and Water Resources

Southport Mall

P.O. Box 10631

Jackson, Mississippi 39209

COASTAL DRILLING & SERVICE CO. WATER WELL DRILLERS LOG

ROUTE 1 BOX 618

BILOXI, MISS 39532

Jackson county well located

Jackson
E 2075

4/16/82 date well completed

LANDOWNER: George Thomas

description of formations encountered

from to

Rt 6 Box 446
Ocean Springs, MS
(mailing address)

Topsoil	1	3
Red Clay	3	15
Green Sand	15	40
Clay white sand	40	105
Salt Blue Clay	105	270
Red Blue Clay	270	420
fine water sand	420	450
Good water sand	450	475

WELL LOCATION:

sec 23 T 5 S R 9 E
5 miles North of Jackson
(distance) (direction) (nearest town)

WELL PURPOSE:

home (home, irrigation, municipal, industrial)

WELL COMPLETION DATA:

- (1) diameter (inches) 4 1/2"
- (2) total depth (feet) 475'
- (3) static water level (feet) 46' below top of ground
- (4) casing PVC 480' (material) (depth)
4 1/2" (size) if telescope see back.
- (5) screen 15' 480' (length) (depth to top)
2" (size) PVC (material)
- (6) pump 1/2 HP 30 (yield gpm)
1/2 (type power)
- (7) electric log no (yes or no)

(organization running log)

(8) how well bottom plugged

2" well bottom plugged
DRILLERS REMARKS: 19-B

DEPT. OF NATURAL RESOURCES
BUREAU OF LAND & WATER RESOURCES

OCT 14 1982

RECEIVED


If well telescopes please sketch and show depths.

GROUND LEVEL

160' 4" P.C. Casing



320' 2" P.C. Casing

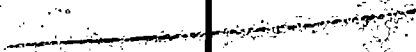


15' 2" P.C. Casing

2" Dash Wire Valve

14-5

If more than one screen, show locations of each on sketch.

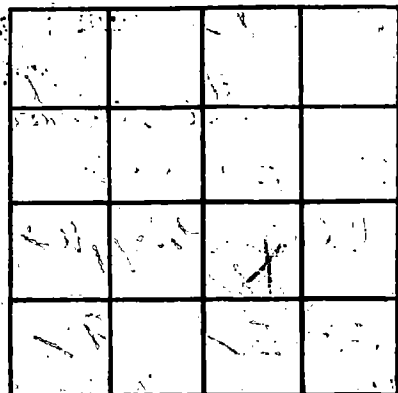

SECTION _____

Please indicate well location X.

ADDITIONAL INFORMATION

Multiple horizontal lines for additional information.