

MISSISSIPPI DEPARTMENT OF NATURAL RESOURCES

Bureau of Land and Water Resources

Southport Mall

P.O. Box 10631

Jackson, Mississippi 39209

COASTAL DRILLING & SERVICE CO. WATER WELL DRILLERS LOG

ROUTE 1 BOX 618

*Jackson*  
E 2076

*Jackson*

date well completed

19

firm name

county well located

LANDOWNER

description of formations encountered

from

to

*Ray Vance*  
Rt 6 Box 440  
*Oliver Springs Mo*  
(mailing address)

<i>top soil</i>	1	3
<i>red clay</i>	3	18
<i>grey silt</i>	18	40
<i>clay white sand</i>	40	100
<i>soft blue clay</i>	100	285
<i>hard blue clay</i>	285	430
<i>fine white sand</i>	430	460
<i>good white sand</i>	460	500

WELL LOCATION:

sec *23* T *5* R *9*  
*5* miles North *Fort Worth*  
(distance) (direction) (nearest town)

WELL PURPOSE:

(home, irrigation, municipal, industrial)

WELL COMPLETION DATA:

- (1) diameter (inches) *2"*
- (2) total depth (feet) *500'*
- (3) static water level (feet) *46* <sup>below</sup> <sub>above</sub> top of ground
- (4) casing *px* (material), *490'* (depth)
- (size) if telescope see back.
- (5) screen *10'* (length), *490'* (depth to top)
- 2"* (size), *px* (material)
- (6) pump *12* (HP), *12* (yield gpm)
- ele* (type power)
- (7) electric log *no* (yes or no)

(organization running log)

(8) has well bottom plugged

DRILLERS REMARKS:

*17-13*


DEPT. OF NATURAL RESOURCES  
BUREAU OF LAND & WATER RESOURCES

OCT 14 1982

RECEIVED

If well telescopes please sketch and show depths.

GROUND LEVEL

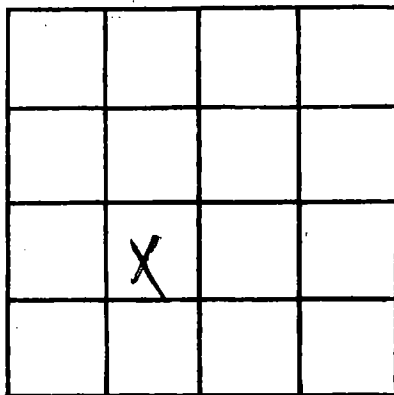

SECTION \_\_\_\_\_

Please indicate well location X.

ADDITIONAL INFORMATION

If more than one screen, show locations of each on sketch.