

MISSISSIPPI DEPARTMENT OF NATURAL RESOURCES

Bureau of Land and Water Resources

Southport Mall

P.O. Box 10631

Jackson, Mississippi 39209

WATER WELL DRILLERS LOG

Jackson
E2027

2-8-83

Coast Water Well Sew.

Jackson

date well completed

firm name

county well located

LANDOWNER:

Ed Drumfield
Rt 1 - Box 136A

description of formations encountered

from

to

Ocean Springs, Min.
(mailing address) 38164

Top soil 0 3'

Red Clay 3 25'

Red Coarse sand 25' 40'

Blue Clay 40' 130'

Gray Coarse sand 130' 149'

Blue Clay 149' 305'

Gray fine sand 305' 325'

Blue Clay 325' 328'

Blue Clay & streak of sand 328' 371'

Blue Clay & clam shell 371' 398'

Blue Clay 398' 454'

Blue Clay & clam shell 454' 496'

Gray Coarse sand 496' 526'

WELL LOCATION:

sec. 4 T. 5 N R. 8 E
10 miles NW of VANGLAWE
(distance) (direction) (nearest town)

WELL PURPOSE:

(home, irrigation, municipal, industrial)

Home

WELL COMPLETION DATA:

(1) diameter (inches) 2"
(2) total depth (feet) 526'

(3) static water level (feet) 93' ^{below} top of ground.

(4) casing PVC 516'
(material) (depth)

2"
(size) If telescope see back.

(5) screen 10' 516'
(length) (depth to top)

2" PVC
(size) (material)

(6) pump 2 hp -6-
(HP) (yield gpm)

Elect.
(type power)

(7) electric log No.
(yes or no)

(organization running log)

(8) how well bottom plugged back wash valve

DRILLERS REMARKS:


DEPT. OF NATURAL RESOURCES
BUREAU OF LAND & WATER RESOURCES

APR 27 1983

RECEIVED

If well telescopes please sketch and show depths.

GROUND LEVEL

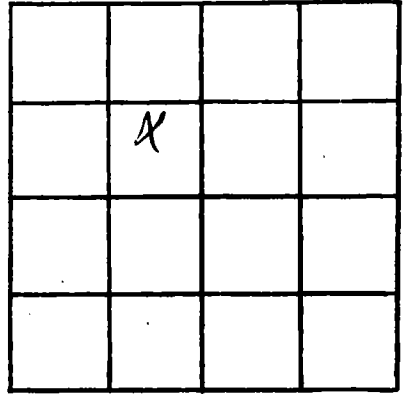

SECTION 4

Please indicate well location X.

ADDITIONAL INFORMATION

If more than one screen,
show locations of each on sketch.