

MISSISSIPPI DEPARTMENT OF NATURAL RESOURCES

Bureau of Land and Water Resources

Southport Mall

P.O. Box 10631

Jackson, Mississippi 39209

WATER WELL DRILLERS LOG

COASTAL DRILLING & SERVICE CO.

Jackson
E 2028

7/1/83
date well completed

ROUTE 1 BOX 618

Jackson
county well located

LANDOWNER: Walter Byrd

BILLOKI, MISS. 39532

description of formations encountered

Vesta Road
Biloki MS
(mailing address)

description of formations encountered	from	to
top soil	1	3
red clay	3	15
white sand	15	30
same	30	35
orange white sand	35	60
soft blue clay	60	210
hard blue clay	210	330
fine white sand	330	345
good water sand	345	370

WELL LOCATION:

sec. 10 T. 5 N. R. 9 E. (W)
2 1/2 miles (distance) Southeast (direction) Logan (nearest town)

WELL PURPOSE:

home
(home, irrigation, municipal, industrial)

WELL COMPLETION DATA:

- (1) diameter (inches) 2"
- (2) total depth (feet) 370'
- (3) static water level (feet) 65 (below/above top of ground)
- (4) casing PVC 360'
(material) (depth)
- (size) If telescope see back.
- (5) screen 10' 360'
(length) (depth to top)
- 2"
(size) PVC
(material)
- (6) pump 1/2 10
(HP) (yield gpm)
- 2e
(type power)
- (7) electric log no
(yes or no)

(organization running log)

(8) how well bottom plugged

2' hard white blue
17-0
DRILLERS REMARKS:


DEPT. OF NATURAL RESOURCES
BUREAU OF LAND & WATER RESOURCES

APR - 5 1984

RECEIVE

If well telescopes please sketch and show depths.

GROUND LEVEL

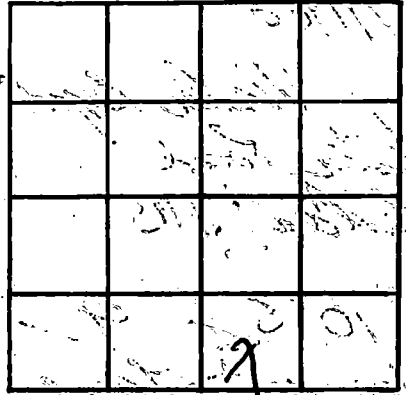

SECTION _____

Please indicate well location X.

ADDITIONAL INFORMATION

If more than one screen,
show locations of each on sketch.