

JACKSON
E 203D

MISSISSIPPI
BOARD OF WATER COMMISSIONERS
416 North State Street
Jackson, Mississippi 39201

WATER WELL DRILLERS LOG

3-12-1986 date well completed
Price Drilling Co firm name
Jackson county well located

LANDOWNER: Lee Patten
Ratimer

description of formations encountered	from	to
Top Soil	0	10
Clay	10	25
Clay & Sand	25	65
Clay	65	370
Good Sand	370	390

Ocean Springs, Ms
(mailing address)

WELL LOCATION:
sec. 3 T. 5 N R. 8 E
6 miles South of Oshtemo
(distance) (direction) (nearest town)

WELL PURPOSE:
(Home, Irrigation, municipal, industrial)

- WELL COMPLETION DATA:
- (1) diameter (inches) 2"
 - (2) total depth (feet) 390'
 - (3) static water level (feet) 50' below above top of ground.
 - (4) casing Plastic, 380' (material) (depth)
 - (size) If telescope see back.
 - (5) screen 10', 390' (length) (depth to top)
 - (size) plastic (material)
 - (6) pump 1 (HP) 10 (yield gpm)
 - electric (type power)
 - (7) electric log (yes or no)
 - (organization running log)
 - (8) how well bottom plugged BW


DRILLERS REMARKS:

RECEIVED

MAR 19 1986

If well telescopes please sketch and show depths.

GROUND LEVEL

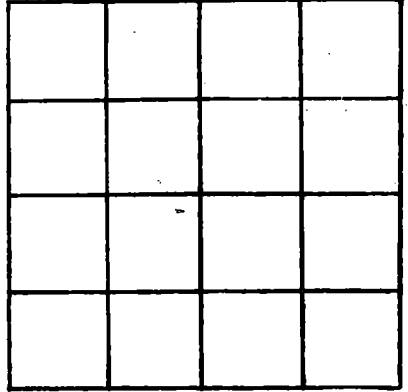

SECTION _____

Please indicate well location X.

ADDITIONAL INFORMATION

If more than one screen, show locations of each on sketch.