

MISSISSIPPI DEPARTMENT OF NATURAL RESOURCES

Bureau of Land and Water Resources

Southport Mall

P.O. Box 10631

Jackson, Mississippi 39209

WATER WELL DRILLERS LOG

Jackson
E 2031

7-3-80 19 Coast water well Jackson
date well completed firm name county well located

LANDOWNER: Lynn Rouse
20,000 Farm Rd
Vandover, Mo
(mailing address)

WELL LOCATION:
sec. 2 T. 5 N. R. 8 E.
8 miles NW of Vandover
(distance) (direction) (nearest town)

WELL PURPOSE: home
(home, irrigation, municipal, industrial)

WELL COMPLETION DATA:

(1) diameter (inches) 2"

(2) total depth (feet) 284'

(3) static water level (feet) 103' below top of ground

(4) casing PUC, 259'
(material) (depth)
2" (size) If telescope see back.

(5) screen 20', 259'
(length) (depth to top)
2" (size) PUC (material)

(6) pump 2 (HP) 7 1/2 (yield gpm)
Elect. (type power)

(7) electric log no (yes or no)

(organization running log)

description of formations encountered	from	to
top soil	0	1
Red Clay	1	18
purple Clay	18	40
Red med sand	40	48
2" Rock	48	-
Blue Clay	48	144
Gray coarse sand	144	155
Blue Clay	155	256
Gray med. sand	256	279
Blue Clay	279	284

RECEIVED

AUG 28 1986


Department of Natural Resources
Bureau of Land & Water Resources

(8) how well bottom plugged
packed with water

DRILLERS REMARKS:
5" 2" PUC tail pipe

If well telescopes please sketch and show depths.

GROUND LEVEL

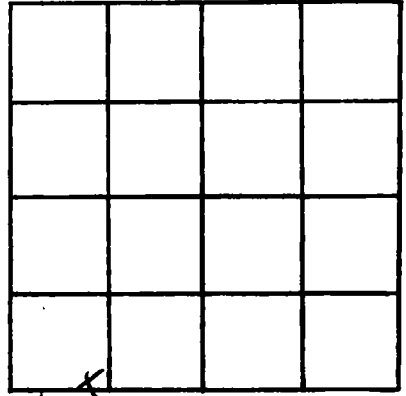

SECTION 2

Please indicate well location X.

ADDITIONAL INFORMATION

If more than one screen, show locations of each on sketch.