

MISSISSIPPI DEPARTMENT OF NATURAL RESOURCES
Bureau of Land and Water Resources

P.O. Box 10631

Jackson, Mississippi 39209

WATER WELL DRILLERS LOG

COUNTY WELL LOCATED Jackson	
WELL NUMBER E 2033	CODED
DATE WELL COMPLETED July 14 1987	

PERMIT NUMBER D-239
NAME OF WELL RT1 BOX 1643 CANAL RD
GUPT, MS 39503

NAME & MAILING ADDRESS OF LANDOWNER Rennie Lee			
WELL LOCATION:			
SEC	TOWNSHIP	RANGE	
25	5	N	9
DISTANCE DIRECTION NEAREST TOWN			
8 Miles	North of	Woodmarket	
OTHER LANDMARK			
WELL PURPOSE <input checked="" type="radio"/> Home, <input type="radio"/> Irrigation, <input type="radio"/> Municipal, <input type="radio"/> Industrial, <input type="radio"/> Fish Pond, etc.			

PUMP DATA		
PUMP TYPE (Circle One): Submersible, Turbine, Jet Flowing Well, Other (Describe) _____		
POWER TYPE (Circle One): Electric , Tractor, Diesel, Gasoline, Butane, Other (Describe) _____		
Pump Capacity (GPM) 13	No. of Stages 2	Setting Depth 100' FT.
PUMP TEST		
Well yielded 8 GPM with a drawdown of 10 ft. after 1 hours of pumping		

WELL DATA		
Well Depth 260'	Casing Diameter (In.) 2" 2"	Casing Length (Ft.) 250'
Type of Casing PVC	Hole Depth 260'	Depth to Static Water Level 78'
TYPE OF COMPLETION: (Circle One or More): <input checked="" type="radio"/> Gravel Packed, <input type="radio"/> Underreamed, <input type="radio"/> Telescoped, <input checked="" type="radio"/> Natural Development, <input type="radio"/> Open Hole, <input type="radio"/> Other (Describe) _____		
Top of Lap Pipe or Reduction in Casing		
FEET IF TELESCOPED OR MORE THAN ONE SCREEN: USE BACK PAGE		

LOG DATA	
TYPE OF LOG RUN (Circle One): No Log Run. Electric, Gamma Ray, Density, Sonic, Neutron, Other (Describe) _____	
Name of Organization Running Log	

SCREEN DATA		
Diameter - Inches 2"	Length - Feet 10'	Slot Size - Inches 6ths
Screen Type PVC		Depth to Bottom - Feet 260'

GEOLOGIC DATA (Office Use Only)			
Surface Elev.	Geologic Unit	Unit Thickness	Depth to Top
Subs. SWL	Date	Analysis	Aquifer Test


Driller's Remarks
RECEIVED

DESCRIPTION OF FORMATIONS ENCOUNTERED	FROM	TO	FORMATIONS (Continued)	
			FROM	TO
mud	0	10	JUL 24 1987 Department of Natural Resources Bureau of Land & Water Resources	
Sand	10	40		
mud	40	1160		
Sand	1160	170		
mud	170	210		
Sand	210	260		

IF MORE SPACE IS NEEDED, USE BACK

If well telescopes please sketch and show depths.

GROUND LEVEL

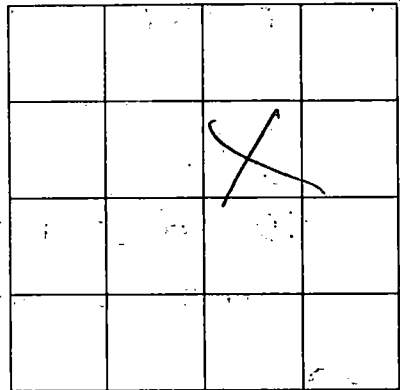

SECTION _____

Please indicate well location X.

ADDITIONAL INFORMATION

Lined area for additional information.

If more than one screen, show location of each on sketch.