

MISSISSIPPI DEPARTMENT OF NATURAL RESOURCES

Bureau of Land and Water Resources

P.O. Box 10631

Jackson, Mississippi 39209

WATER WELL DRILLERS LOG

COUNTY WELL LOCATED Jackson	
WELL NUMBER E2035	CODED
DATE WELL COMPLETED 9-20-89	

PERMIT NUMBER 0408
NAME OF DRILLING FIRM Woodwell MS
Traylor Well Son

NAME & MAILING ADDRESS OF LANDOWNER John Young 11017 John's Bayou Rd Ocean Springs MS 39564			
WELL LOCATION:	SEC	TOWNSHIP	RANGE
	24	T5	S R 8 E
DISTANCE	DIRECTION	NEAREST TOWN	
5	West	Wade	
OTHER LANDMARK Big Camp Ground			
WELL PURPOSE: Home, Irrigation, Municipal, Industrial, Fish Pond, etc.			

PUMP DATA		
PUMP TYPE (Circle One): <input checked="" type="radio"/> Submersible, Turbine, Jet, Flowing Well, Other (Describe) _____		
POWER TYPE (Circle One): <input checked="" type="radio"/> Electric, Tractor, Diesel, Gasoline, Butane, Other (Describe) _____ H/P 1		
Pump Capacity (GPM)	No. of Stages	Setting Depth
19	2	122' FT.
PUMP TEST		
Well yielded 30+ GPM with a drawdown of 10 ft. after 2 hours of pumping		

WELL DATA		
Well Depth 125	Casing Diameter (In.) 4"	Casing Length (Ft.) 95
Type of Casing PVC	Hole Depth 125	Depth to Static Water Level 60
TYPE OF COMPLETION: (Circle One or More): Gravel Packed, Underreamed, Telescoped, Natural Development, Open Hole, Other (Describe) _____		
Top of Lap Pipe or Reduction in Casing None		
FEET		
IF TELESCOPED OR MORE THAN ONE SCREEN: USE BACK PAGE		

LOG DATA	
TYPE OF LOG RUN (Circle One): Electric, Gamma Ray, Density, Sonic, Neutron, Other (Describe) _____	
Name of Organization Running Log	

SCREEN DATA		
Diameter - Inches 4" x 2"	Length - Feet 30	Slot Size - Inches # 8
Screen Type PVC Sawn	Depth to Bottom - Feet 125'	


GEOLOGIC DATA (Office Use Only)			
Surface Elev.	Geologic Unit	Unit Thickness	Depth to Top
Subs. SWL	Date	Analysis	Aquifer Test
Driller's Remarks			

DESCRIPTION OF FORMATIONS ENCOUNTERED	FROM	TO
Faf Silt	0	5
Red Silt	5	20
red sandy clay	20	30
red sand	30	50
clay	50	80
Sandy clay	80	105
Sand.	105	125


FORMATIONS (Continued)	FROM	TO
NOV 07 1989		
Department of Natural Resources Bureau of Land & Water Resources		
IF MORE SPACE IS NEEDED, USE BACK		

If well telescopes please sketch and show depths.

GROUND LEVEL

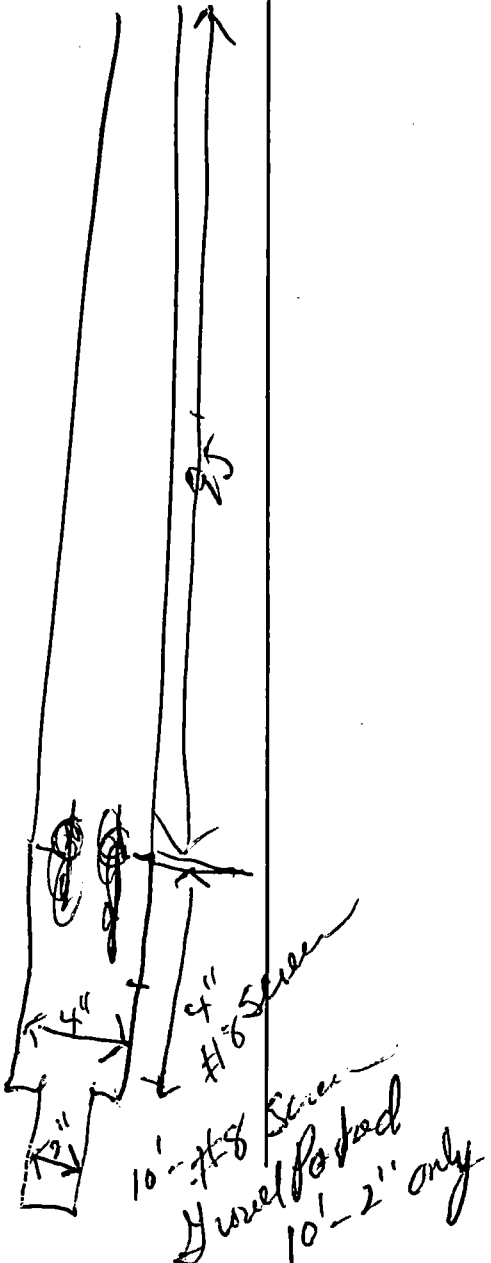

If more than one screen, show location of each on sketch.

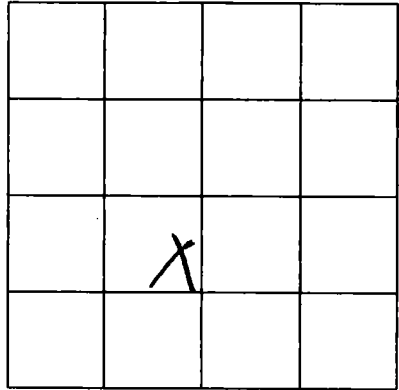

SECTION

24

Please indicate well location X.

ADDITIONAL INFORMATION

A series of horizontal lines for writing additional information.