

MISSISSIPPI DEPARTMENT OF ENVIRONMENTAL QUALITY

Office of Land and Water Resources

P. O. Box 10631
Jackson, MS 39289-0631
WATER WELL DRILLERS LOG

COUNTY, WELL LOCATED
Jackson

WELL NUMBER
E 2946

CODED

DATE WELL COMPLETED
3-29-96

PERMIT NUMBER

NAME OF DRILLING FIRM
Coast Water Well Service

NAME & MAILING ADDRESS OF LANDOWNER
Randall Moran
Larue Rd.
Larue, Ms

WELL LOCATION SEC *13* TOWNSHIP *S* RANGE *9* *W*

DISTANCE *1 1/2* Miles DIRECTION *S* of NEAREST TOWN *Larue*

OTHER LANDMARK

WELL PURPOSE Home Irrigation, Municipal, Industrial, Fish Pond, etc.

PUMP DATA

PUMP TYPE (Circle One):
Submersible, Turbine, Jet, Flowing Well,
Other (Describe)

POWER TYPE (Circle One):
 Electric, Tractor, Diesel, Gasoline, Butane,
Other (Describe) *H/P 2*

Pump Capacity (GPM) *10* No. of Stages *3* Setting Depth *FT.*

PUMP TEST

Well yielded _____ GPM with
a drawdown of _____ ft.
after _____ hours of pumping

WELL DATA

Well Depth *492'* Casing Diameter (In.) *2"* Casing Length (Ft.) *485'*

Type of Casing *PVC* Hole Depth *492'* Depth to Static Water Level *80'*

LOG DATA

TYPE OF LOG RUN (Circle One):
Electric, Gamma Ray, Density, Sonic, Neutron, No Log Run,
Other (Describe)

Name of Organization Running Log

TYPE OF COMPLETION: (Circle One or More):
 Gravel Packed, Underreamed, Telescoped,
 Natural Development, Open Hole, Other

GEOLOGIC DATA (Office Use Only)

Surface Elevation	Geologic Unit #	Unit Thickness	Depth to Top
Surface Elevation	Unit #	Aquifer	Aquifer Test

WELL GROUTED TO A DEPTH OF *20* FEET
Type Grout (circle one): Cement, Bentonite, or Mix

Driller's Remarks
RECEIVED
MAY 14 1996

SCREEN DATA

Diameter - Inches *2"* Length - Feet *10'* Slot Size - Inches *.008*

Screen Type *PVC* Depth to Bottom - Feet *492'*


Top Dept. of Environmental Quality
Office of Land & Water Resources
FEET MORE THAN ONE SCREEN: USE BACK PAGE

DESCRIPTION OF FORMATIONS ENCOUNTERED	FROM	TO	FORMATIONS (Continued)	FROM	TO
<i>Top Soil</i>	<i>0</i>	<i>2'</i>			
<i>Red Clay</i>	<i>2</i>	<i>21</i>			
<i>White Coarse Sand</i>	<i>21</i>	<i>33</i>			
<i>Blue Clay</i>	<i>33</i>	<i>60</i>			
<i>White coarse sand gravel</i>	<i>60</i>	<i>66</i>			
<i>Blue Clay</i>	<i>66</i>	<i>465</i>			
<i>grey coarse sand</i>	<i>465</i>	<i>492</i>			

IF MORE SPACE IS NEEDED, USE BACK

If well telescopes please
sketch and show depths.

GROUND LEVEL

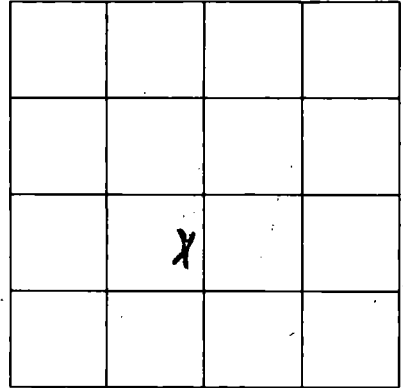

SECTION 13

Please indicate well location X.

ADDITIONAL INFORMATION

If more than one screen,
show location of each on sketch.