

JACKSON

~~F 14~~

9-29-60

WATER WELL DRILLERS LOG

Date: Sept 29, 1960, Drillers: C. T. Switzer Well Co. County Jackson
 (Name)

(1) Owner of Land: New Prospect Methodist Church.
 (Name)
Canalvey, Miss.
 (Address)

(2) Location: NW 1/4, SW 1/4, Sec. 19 T55R7W
5 miles N, of Canalvey
 (distance) (direction) (Nearest Town)

(3) Topography: (Hilly) (Flat) (Level)

(4) Purpose of Well: domestic
 (Domestic Irrigation, Municipal, Industrial, Other)

Description & Color of Materials Sand, Clay, Red Clay, Shell, etc.	Thick- ness Feet	Depth Feet
red clay	0	20
sand	20	24
red clay	24	33
clay - white	33	50
sand	50	59
clay	59	80
sand	80	103
clay - yellow	103	170
clay - blue	170	209
sand - good	209	216
blue clay	216	290
sand - fine	290	299
clay	299	300
sand	300	303
clay	303	461
stratified	461	466
clay	466	551
shells - fine sand	551	565
clay	565	655
fine sand	655	672
clay	672	692
shale	692	711
clay & shale	711	729
fine sand	729	741
clay & shale	741	762
sand - good	762	800
sand - shale streaks	800	822

Information upon completion of well:

(1) Diameter 3 inches.

(2) Total Depth 781 feet.

(3) Water Level -29' feet below top of ground.

(4) Cased to 781', Size 3"


(5) Screen: Size 10 ga., Length 10'

(6) Were any formations sealed against pollution?
 yes, no.

If YES depth of formation 10 feet

Why Health dept. requirement

Drillers Remarks:

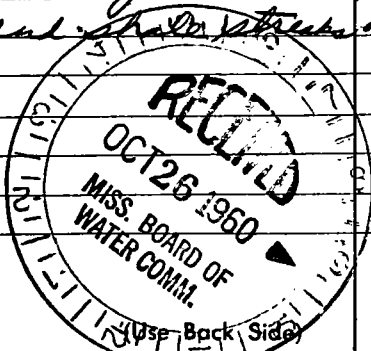

Well No.

