

JACKSON

F 34

WATER WELL DRILLERS LOG

CODED

Date: Jan 14, 1963, Driller: Andrew Colville County Jackson
 49 (Name)

(1) Owner of Land: Rose Furby
 (Name)
Wavelave Miss
 (Address)

(2) Location: NW 1/4, SE 1/4, Sec. 23 T55R74
6 miles NE, of Wavelave
 (distance) (direction) (Nearest Town)

(3) Topography: Hilly
 (Hilly) (Flat) (Level)

(4) Purpose of Well: Domestic
 (Domestic Irrigation
 Municipal, Industrial, Other)

Description & Color of Materials Sand, Clay, Red Clay, Shell, etc.	Thick- ness Feet	Depth Feet
0-21 Red clay		
21-42 muddy sand		
42-68 sand		
68-257 clay		
257-273 sand TD		

Information upon completion of well:

(1) Diameter 2" inches.

(2) Total Depth 273 feet.

(3) Water Level 103 feet below top of ground.

(4) Cased to _____, Size _____

(5) Screen: Size 2", Length 10'


(6) Were any formations sealed against pollution?
 _____ yes, X no.

If YES depth of formation _____

Why _____

Drillers Remarks: _____

CODED

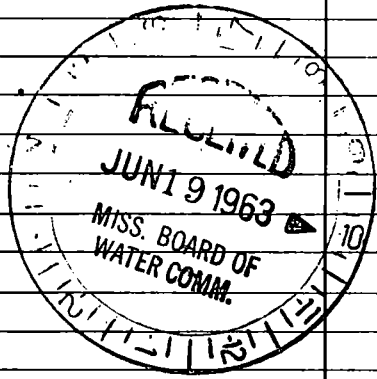

Well No.
186

(Use Back Side)

1940

1940