

JACKSON MISSISSIPPI BOARD OF WATER COMMISSIONERS

F 35

3-29-63

WATER WELL DRILLERS LOG

CODED

Date: March 29 1963, Driller: George Colville County Jackson
(Name)
59

(1) Owner of Land: Roy Stevens
(Name)
Quatier Miss
(Address)

(2) Location: N 1/4, NE 1/4, Sec. 11 T5R7E4
24 miles NW of Pascagoula
(distance) (direction) (Nearest Town)

(3) Topography: Flat
(Hilly) (Flat) (Level)

(4) Purpose of Well: Domestic
(Domestic Irrigation
Municipal, Industrial, Other)

Description & Color of Materials Sand, Clay, Red Clay, Shell, etc.	Thick- ness Feet	Depth Feet
<u>Sand</u>		<u>10</u>
<u>Clay</u>	<u>56</u>	<u>66</u>
<u>Sand</u>	<u>100</u>	<u>166</u>
<u>Clay</u>	<u>32</u>	<u>198</u>
<u>Sand</u>	<u>44</u>	<u>242</u>

Information upon completion of well:

(1) Diameter 1 1/4 inches.

(2) Total Depth 242 feet.

(3) Water Level 22' feet below top of ground.

(4) Cased to _____, Size _____.

(5) Screen: Size 1 1/4, Length 10.


(6) Were any formations sealed against pollution?
 _____ yes, no.

If YES depth of formation _____

Why _____

Drillers Remarks: _____

CODED

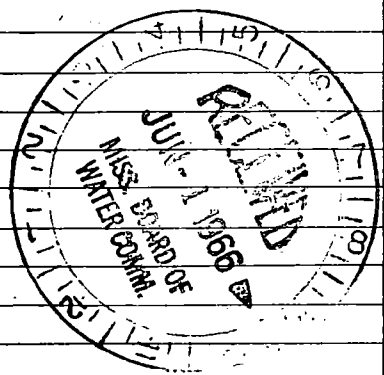

(Use Back Side)

Well No. 207

000000

000000