

F 36

9-66

WATER WELL DRILLERS LOG

CODED

Date: Sept 13, 1966, Driller: T. O. STARK (COLVILLE) County Jackson
 4 4 (Name)

(1) Owner of Land: R. V. Overstreet
 (Name)
Vanzalezue Miss.
 (Address)

(2) Location: NE 1/4, NE 1/4, Sec. 23 T53R7W
7 miles N. of Vanzalezue
 (distance) (direction) (Nearest Town)

(3) Topography: Hilly
 (Hilly) (Flat) (Level)

(4) Purpose of Well: Dom.
 (Domestic Irrigation
 Municipal, Industrial, Other)

Description & Color of Materials Sand, Clay, Red Clay, Shell, etc.	Thick- ness Feet	Depth Feet
Clay & Sand STRKS	22	22
SAND	44	66
CLAY	119	185
SAND	10	195
SAND & CLAY STRKS	3	198
CLAY	27	225
SAND	33	258

Information upon completion of well:

(1) Diameter 2 inches.

(2) Total Depth 258 feet.

(3) Water Level 90 feet below top of ground.

(4) Cased to 253, Size 2 in.

(5) Screen: Size 80 ga., Length 5 ft.


(6) Were any formations sealed against pollution?
 _____ yes, no.

CODED

If YES depth of formation _____

Why _____

Drillers Remarks: _____

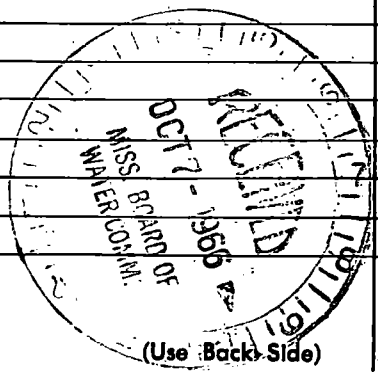

Well No.

000000

000000