

44

Jackson

F 37

4-67

MISSISSIPPI BOARD OF WATER COMMISSIONERS 416 North State Street Jackson, Mississippi 39201

WATER WELL DRILLERS LOG

CODED

4-21 1967 date well completed

67 Coast Water Well Dr Jackson firm name

county well located

LANDOWNER: George Edwards

Description of formations encountered

from to

Vanleaves

Red Clay

0 20

Ocean Springs Rural Route (mailing address)

Sand and Gravel

20 48

Blue Clay

48 184

Sand and Gravel

184 204

WELL LOCATION:

sec. 40 T 5 N R 7 E 5 miles North of Vanleaves (distance) (direction) (nearest town)

WELL PURPOSE: Home (home, irrigation, municipal, industrial)

CODED

WELL COMPLETION DATA:

(1) diameter (inches) 2"

(2) total depth (feet) 204

(3) static water level (feet) 70 below top of ground

(4) casing Galv. 194 (material) (depth)

2" (size) If telescope see back.

(5) screen 10' 194 (length) (depth to top)

2" (size) Stainless Steel (material)

(6) pump 1 500 (HP) (yield gpm)


Elect (type power)

(7) electric log NO (yes or no)

(organization running log)

(8) how well bottom plugged Backwash Valve

DRILLERS REMARKS:

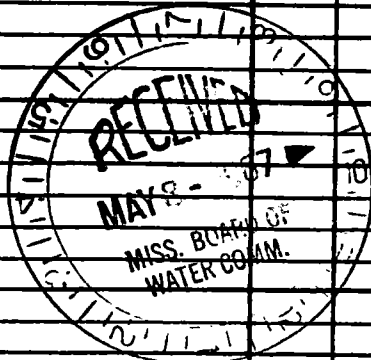

If well telescopes please sketch and show depths.

2100

GROUND LEVEL

Vertical column for well sketches and depth measurements.

2100

NE NW

	X		

SECTION 40

Please indicate well location X.

ADDITIONAL INFORMATION

Horizontal lines for additional information.

If more than one screen, show locations of each on sketch.