

40

JACKSON
738
7-67

MISSISSIPPI
BOARD OF WATER COMMISSIONERS
416 North State Street
Jackson, Mississippi 39201

CODED

WATER WELL DRILLERS LOG

7-31 1967 Coastwater Well Service Jackson
date well completed firm name county well located

LANDOWNER: Roy Butler
Vandewater, Miss
(mailing address)

| description of formations encountered | from | to |
|---------------------------------------|------|-----|
| Red Clay | 0 | 21 |
| hard fine-grained blue clay shale | 21 | 37 |
| hard med-coarse | 37 | 200 |
| | 200 | 231 |


WELL LOCATION:
sec. 35 T 5 N R 7 E
S W
6 miles North of Vandewater
(distance) (direction) (nearest town)

WELL PURPOSE: Home
(home, irrigation, municipal, industrial)

WELL COMPLETION DATA:

(1) diameter (inches) 2"
(2) total depth (feet) 231
(3) static water level (feet) 78 below top of ground.
(4) casing 2" galv. 221, (material) (depth)
If telescope see back.
(size)
(5) screen 10' 221 (length) (depth to top)
2" stainless steel (size) (material)
(6) pump 1 (HP) 6 (yield gpm)
Elect (type power)
(7) electric log NO (yes or no)
(organization running log)
(8) how well bottom plugged Back wash valve

CODED

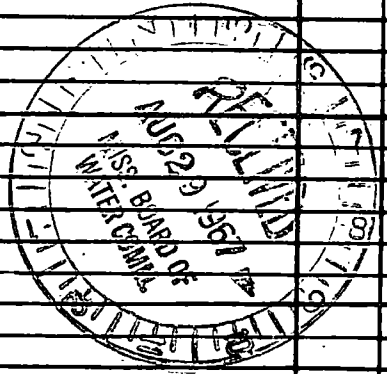

DRILLERS REMARKS:

If well telescopes please sketch and show depths.



SW SE


GROUND LEVEL

| | | | |
|--|--|---|--|
| | | | |
| | | | |
| | | | |
| | | X | |

SECTION 35

Please indicate well location X.

ADDITIONAL INFORMATION

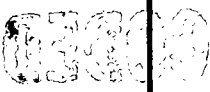

If more than one screen, show locations of each on sketch.