

JACKSON
740
9-67

MISSISSIPPI
BOARD OF WATER COMMISSIONERS
416 North State Street
Jackson, Mississippi 39201

WATER WELL DRILLERS LOG **CODED**
 19 COAST WATER WELL SERVICE JACKSON
 date/well completed firm name county well located

LANDOWNER R. GLENN WILSON

description of formations encountered	from	to

R1 BOX 275
OCEAN SPRINGS MISS.
 (mailing address)

<u>RED CLAY</u>	<u>0</u>	<u>15</u>
<u>PINK SAND - MED - FINE</u>	<u>15</u>	<u>20</u>
<u>BLUE CLAY</u>	<u>RD</u>	<u>225</u>
<u>FINE SAND - MED.</u>	<u>225</u>	<u>246</u>


WELL LOCATION:
 sec. 19 T. 5 N. R. 2 W.
8 miles No. of LANICLERVE
 (distance) (direction) (nearest town)

WELL PURPOSE: HOME
 (home, irrigation, municipal, industrial)

WELL COMPLETION DATA:

- (1) diameter (inches) 2"
- (2) total depth (feet) 246'
- (3) static water level (feet) 90' below top of ground.
- (4) casing GALV. 236'
 (material) (depth)
2"
 (size) if telescope see back.
- (5) screen 10' 236'
 (length) (depth to top)
2" STAINLESS
 (size) (material)
- (6) pump 1 8
 (HP) (yield gpm)
ELECTRIC
 (type power)
- (7) electric log NO
 (yes or no)
 (organization running log)
- (8) how well bottom plugged BACK
WASH VALVE

CODED

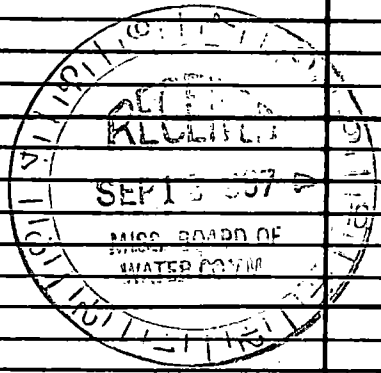

DRILLERS REMARKS:

