

40
Jackson
741
11-67

MISSISSIPPI
 BOARD OF WATER COMMISSIONERS
 416 North State Street
 Jackson, Mississippi 39201

5

CODED

WATER WELL DRILLERS LOG

11-14-67 19 COAST WATER, WELL SERVICE JACKSON
 date well completed firm name county well located

LANDOWNER: W.C. Busby Sr.

description of formations encountered

from to

DANCLARE

RED CLAY
MED SAND
BLUE CLAY
FINE SAND

0 19
19 74
74 160
166 178

(mailing address)

WELL LOCATION:

sec. 18 T. 5 N. R. 7 E
 S W
6 miles North of Hammond
 (distance) (direction) (nearest town)

WELL PURPOSE: Home
 (home, irrigation, municipal, industrial)

WELL COMPLETION DATA:


- (1) diameter (inches) 2"
- (2) total depth (feet) 178'
- (3) static water level (feet) 65' below top of ground.
- (4) casing Galv. 168'
 (material) (depth)
- 2" If telescope see back.
 (size)
- (5) screen 10' 168'
 (length) (depth to top)
- 2" PLASTIC
 (size) (material)
- (6) pump 1 8
 (HP) (yield gpm)
- Elect
 (type power)
- (7) electric log NO
 (yes or no)

(organization running log)

(8) how well bottom plugged 2" BACK
WASH VALVE

DRILLERS REMARKS:

CODED

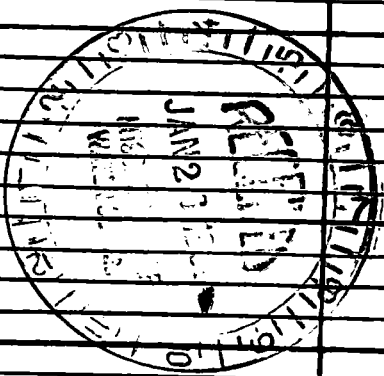

If well telescopes please sketch and show depths.

01003

GROUND LEVEL

NW NE

| | | | |
|--|--|---|--|
| | | X | |
| | | | |
| | | | |
| | | | |

SECTION 18

Please indicate well location X.

ADDITIONAL INFORMATION

01003

If more than one screen, show locations of each on sketch.