

40

Jackson
742
11-67

MISSISSIPPI
BOARD OF WATER COMMISSIONERS
416 North State Street
Jackson, Mississippi 39201

6

WATER WELL DRILLERS LOG

CODED

11-21-67
date well completed

COAST WATER WELL SERVICE
firm name

county well located

LANDOWNER: W.D. BUSBY JR.

VANCE LAKE

(mailing address)

WELL LOCATION:

sec. 18 T 5 N R 7 E
S W
6 miles North of Vandover
(distance) (direction) (nearest town)

WELL PURPOSE: Home
(home, irrigation, municipal, industrial)

WELL COMPLETION DATA:

- (1) diameter (inches) 2"
- (2) total depth (feet) 39
- (3) static water level (feet) 20' below top of ground.
- (4) casing GALV. 34'
(material) (depth)
- 2" if telescope see back.
(size)
- (5) screen 5' 34'
(length) (depth to top)
- 2" PLASTIC
(size) (material)
- (6) pump 1 10
(HP) (yield gpm)
- Elect.
(type power)
- (7) electric log NO
(yes or no)

(organization running log)

(8) how well bottom plugged 2" BACK
WASH OIL

DRILLERS REMARKS:

description of formations encountered

from to


RED CLAY 0 19
COARSE SAND GRAVEL 19 39

CODED



If well telescopes please sketch and show depths.

GROUND LEVEL

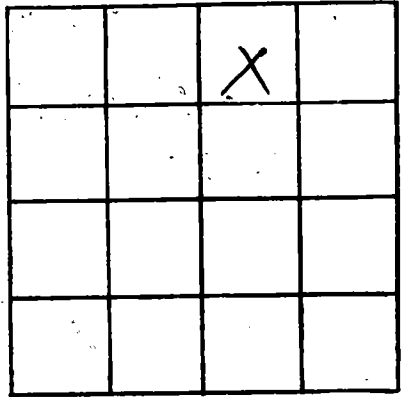

SECTION 18

Please indicate well location X.

ADDITIONAL INFORMATION

If more than one screen, show locations of each on sketch.