

Jackson
744
9-13-66

MISSISSIPPI
 BOARD OF WATER COMMISSIONERS
 416 North State Street
 Jackson, Mississippi 39201
 WATER WELL DRILLERS LOG

CODED

Sept 13 1966 La Cabille Water Supply Jackson
 date well completed firm name county well located

LANDOWNER: <u>K.V. Overstreet</u>	description of formations encountered	from	to
<u>Vancelease, Miss.</u> (mailing address)	<u>Sandy clay</u>	<u>0</u>	<u>22</u>
WELL LOCATION: sec. <u>24</u> T. <u>5</u> N. R. <u>7</u> E. <u>4.5</u> miles <u>N</u> of <u>Vancelease</u> (distance) (direction) (nearest town)	<u>sand</u>	<u>22</u>	<u>44</u>
WELL PURPOSE: <u>Home</u> (home, irrigation, municipal, industrial)	<u>clay</u>	<u>44</u>	<u>225</u>
WELL COMPLETION DATA: (1) diameter (inches) <u>2"</u> (2) total depth (feet) <u>258</u> (3) static water level (feet) <u>90</u> <u>below</u> top of ground. (4) casing <u>galv.</u> (material) (depth) _____ _____ If telescope see back. (size) (5) screen _____ (length) _____ (depth to top) _____ (size) _____ (material) (6) pump <u>1</u> (HP) <u>5</u> (yield gpm) <u>elec</u> (type power) (7) electric log <u>no</u> (yes or no) _____ (organization running log) (8) how well bottom plugged <u>B.P. valve</u>	<u>sand</u>	<u>225</u>	<u>258</u>
DRILLERS REMARKS:			


CODED

APR 21 1968

MISS. BD. OF WATER COM.

If well telescopes please sketch and show depths.

GROUND LEVEL

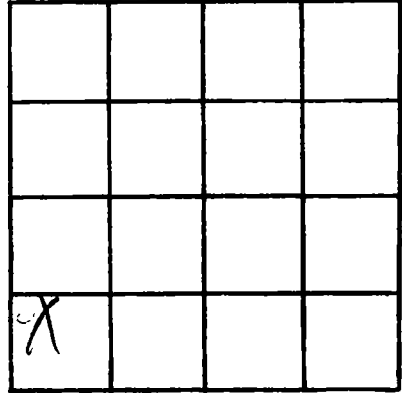

SECTION 24

Please indicate well location X.

ADDITIONAL INFORMATION

If more than one screen, show locations of each on sketch.