

Jackson  
745  
4-8-67

MISSISSIPPI  
BOARD OF WATER COMMISSIONERS  
416 North State Street  
Jackson, Mississippi 39201

CODED

WATER WELL DRILLERS LOG

April 8 1967 Chalk Water Dring Jackson  
date well completed firm name county well located


LANDOWNER: <u>Harry S. Krebs</u>	description of formations encountered	from	to
<u>Shantin Miss</u> (mailing address)	<u>clay</u>	<u>0</u>	<u>80</u>
WELL LOCATION: sec. <u>4</u> T. <u>53</u> N. R. <u>7</u> E <u>7</u> miles <u>NE</u> of <u>Van Cluse</u> (distance) (direction) (nearest town)	<u>sand</u>	<u>80</u>	<u>81</u>
WELL PURPOSE: <u>irr</u> (home, irrigation, municipal, industrial)	<u>clay</u>	<u>81</u>	<u>101</u>
WELL COMPLETION DATA: (1) diameter (inches) <u>4</u>	<u>sand</u>	<u>101</u>	<u>190</u>
(2) total depth (feet) <u>140</u>			
(3) static water level (feet) <u>106</u> <sup>below</sup> top of ground			
(4) casing <u>Black iron</u> (material) (depth)			
(5) screen <u>10</u> <u>130</u> (length) (depth to top)			
(6) pump <u>3</u> <u>10</u> (HP) (yield gpm)			
(7) electric log <u>no</u> (yes or no)			
(8) how well bottom plugged <u>BRKley</u>			
DRILLERS REMARKS:			

APR 21 1969

MISS. BD. OF  
WATER COMM.

If well telescopes please sketch and show depths.

GROUND LEVEL

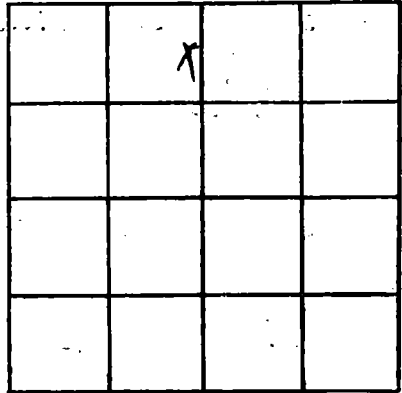

SECTION 11

Please indicate well location X.

ADDITIONAL INFORMATION

A series of horizontal lines for writing additional information.

If more than one screen, show locations of each on sketch.