

**MISSISSIPPI  
BOARD OF WATER COMMISSIONERS**  
416 North State Street  
Jackson, Mississippi 39201

**CODED**

**WATER WELL DRILLERS LOG**

JACKSON  
F48  
4-24-69

4-24 1969 Coast Water Well Serv. Jackson  
date well completed firm name county well located

LANDOWNER: Howard Wilson  
704 Cumberland Dr.  
Pascagoula, Miss.  
(mailing address)

description of formations encountered	from	to
	<u>Surface soil</u>	<u>0</u>
<u>Sand, fine</u>	<u>11</u>	<u>28</u>
<u>White clay</u>	<u>28</u>	<u>38</u>
<u>Blue clay</u>	<u>38</u>	<u>79</u>
<u>Sand, med to coarse</u>	<u>79</u>	<u>126</u>
<u>Blue clay</u>	<u>126</u>	<u>230</u>
<u>Sandy, fine to med.</u>	<u>230</u>	<u>262</u>

WELL LOCATION:  
sec. 29 T. 5 S. R. 7 E.  
3 miles N of Waukegan  
(distance) (direction) (nearest town)

WELL PURPOSE: Home  
(home, irrigation, municipal, industrial)

WELL COMPLETION DATA:

(1) diameter (inches) 2"

(2) total depth (feet) 262'

(3) static water level (feet) 70 below top of ground.

(4) casing Galv. (material), 252' (depth)  
2" (size) if telescope see back.

(5) screen 10' (length), 252' (depth to top)  
2" (size), Stainless Wapped (material)

(6) pump 1 (HP), 8 (yield gpm)  
Elec. (type power)

(7) electric log NO (yes or no)  
(organization running log)

(8) how well bottom plugged Back - Wash Valve

**CODED**


APR 29 1969

MISS. BD. OF  
WATER COMM.

DRILLERS REMARKS:

If well telescopes please sketch and show depths.

GROUND LEVEL

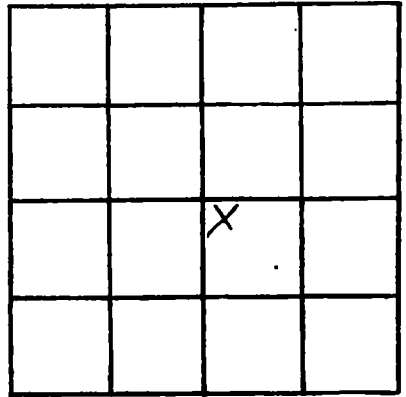

SECTION 29

Please indicate well location X.

ADDITIONAL INFORMATION

A series of horizontal lines for writing additional information, starting below the 'ADDITIONAL INFORMATION' header and extending to the bottom of the page.

If more than one screen, show locations of each on sketch.