

Jackson  
7 49  
5-2-69

MISSISSIPPI  
BOARD OF WATER COMMISSIONERS  
416 North State Street  
Jackson, Mississippi 39201

CODED

WATER WELL DRILLERS LOG

May 2 1969 M. T. & J. Willco Jackson  
date well completed firm name county well located

LANDOWNER:	description of formations encountered	from	to
Donald S. Petterson Vanclave Miss. (mailing address)			
WELL LOCATION: sec. 40 T-5 N R-7 E 3 miles N of Vanclave (distance) (direction) (nearest town)	<del>Gravel &amp; sand</del>	75	83
WELL PURPOSE: Home (home, irrigation, municipal, industrial)			
WELL COMPLETION DATA:			
(1) diameter (inches) 2"			
(2) total depth (feet) 83'			
(3) static water level (feet) 50 <sup>below</sup> above top of ground.			
(4) casing Galv. 78' (material) (depth)			
(size) if telescope see back.			
(5) screen 5' 78' (length) (depth to top)			
2" Plastic (size) (material)			
(6) pump 1 8 (HP) (yield gpm)			
Electric (type power)			
(7) electric log (yes or no)			
(organization running log)			
(8) how well bottom plugged Backwash valve			
DRILLERS REMARKS:			


CODED

JUL 23 1969

MISS. BD. OF  
WATER COMM.

If well telescopes please sketch and show depths.

GROUND LEVEL

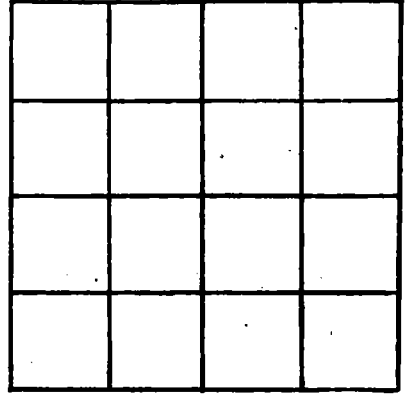

SECTION 40

Please indicate well location X.

ADDITIONAL INFORMATION

If more than one screen, show locations of each on sketch.