

**MISSISSIPPI
BOARD OF WATER COMMISSIONERS**
416 North State Street
Jackson, Mississippi 39201

CODED

WATER WELL DRILLERS LOG


Jackson
F 50
1-10-69

Jan 15 1969 Coille Water Supply Jackson
date well completed firm name county well located

LANDOWNER: <u>C. E. Higgin</u>	description of formations encountered	from	to
<u>Lake O'Pines</u>	<u>Clay</u>	<u>0</u>	<u>66</u>
<u>Waukegan</u> (mailing address)	<u>sand</u>	<u>66</u>	<u>125</u>
WELL LOCATION:	<u>Clay</u>	<u>125</u>	<u>240</u>
sec. <u>29</u> T. <u>5</u> N. R. <u>7</u> E	<u>sand</u>	<u>240</u>	<u>278</u>
<u>3</u> miles <u>N</u> of <u>Waukegan</u>			
WELL PURPOSE: <u>home</u> (home, irrigation, municipal, industrial)			
WELL COMPLETION DATA:			
(1) diameter (inches) <u>2</u>			
(2) total depth (feet) <u>278</u>			
(3) static water level (feet) <u>77</u> <u>below</u> top of ground.			
(4) casing <u>Galv</u> (material) (depth)			
(size) If telescope see back.			
(5) screen <u>5</u> <u>273</u> (length) (depth to top)			
<u>2</u> <u>stainless</u> (size) (material)			
(6) pump <u>1</u> <u>4</u> (HP) (yield gpm)			
<u>elec</u> (type power)			
(7) electric log <u>NO</u> (yes or no)			
(organization running log)			
(8) how well bottom plugged <u>B.P. Valve</u>			
DRILLERS REMARKS:			

If well telescopes please sketch and show depths.

GROUND LEVEL

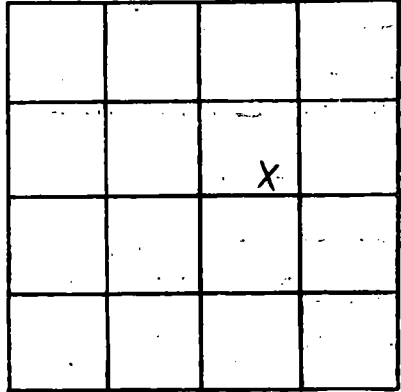

SECTION 29

Please indicate well location X.

ADDITIONAL INFORMATION

If more than one screen, show locations of each on sketch.