

Jackson
 F 51
 5-12-70

MISSISSIPPI
 BOARD OF WATER COMMISSIONERS
 416 North State Street
 Jackson, Mississippi 39201

INDEXED

WATER WELL DRILLERS LOG

5-12-1970 date well completed
 Coast Water Well Service firm name
 Jackson county well located

LANDOWNER: Douglas Hall
 1429 Suter St.
 Biloxi, Miss.
 (mailing address)

description of formations encountered	from to	
	feet	feet
Top Soil + Red Clay	0	20
Sand - Med - coarse	20	60
White Clay	60	90
Sand - fine to med.	90	140
Blue Clay	140	200
Sand - Fine to	200	230
Blue Clay	230	300
Sand - Fine to med.	300	357

WELL LOCATION:
 sec. 30 T. 5 S. R. 7 W. 158
 3 1/2 miles N of Waveland
 (distance) (direction) (nearest town)


WELL PURPOSE: Home
 (home, irrigation, municipal, industrial)

- WELL COMPLETION DATA:
- (1) diameter (inches) 2"
 - (2) total depth (feet) 357'
 - (3) static water level (feet) 100 below top of ground.
 - (4) casing galv. (material) 347' (depth)
2" (size) if telescope see back.
 - (5) screen 10' (length) 347' (depth to top)
2" (size) Stainless Borlug (material)
 - (6) pump 2 (HP) 6 (yield gpm)
elec. (type power)
 - (7) electric log NO (yes or no)
 - (organization running log)
 - (8) how well bottom plugged Back - Wash Valve

DRILLERS REMARKS:

If well telescopes please sketch and show depths.

GROUND LEVEL

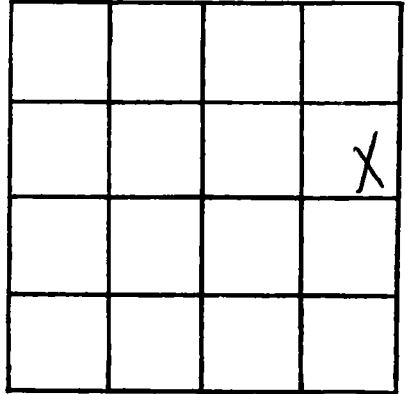

SECTION 30

Please indicate well location X.

ADDITIONAL INFORMATION

If more than one screen, show locations of each on sketch.