

JACKSON  
F52  
8-10-70

MISSISSIPPI  
BOARD OF WATER COMMISSIONERS  
416 North State Street  
Jackson, Mississippi 39201

**CODED**

WATER WELL DRILLERS LOG

Aug 10 1970 Cobalt Water Supply Jackson  
days well completed firm name county well located

LANDOWNER: <u>Charles Kimmaly</u>	description of formations encountered	from	to
<u>Vanclave Miss</u> (mailing address)			
WELL LOCATION: sec <u>18</u> T <u>5</u> N R <u>7</u> E <u>6</u> miles <u>NW</u> of <u>Vanclave</u> (distance) (direction) (nearest town)	<u>Clay</u>	<u>0</u>	<u>26</u>
WELL PURPOSE: <u>home</u> (home, irrigation, municipal, industrial)	<u>sand</u>	<u>26</u>	<u>52</u>
WELL COMPLETION DATA: (1) diameter (inches) <u>2</u>	<u>Clay</u>	<u>52</u>	<u>152</u>
(2) total depth (feet) <u>278</u>	<u>fine sand</u>	<u>152</u>	<u>194</u>
(3) static water level (feet) <u>266</u> <sup>below</sup> / <sup>above</sup> top of ground.	<u>sand</u>	<u>194</u>	<u>278</u>
(4) casing <u>Galv</u> <u>273</u> (material) (depth)			
(size) if telescope see back.			
(5) screen <u>5'</u> <u>273</u> (length) (depth to top)			
<u>2"</u> <u>stainless</u> (size) (material)			
(6) pump <u>1</u> <u>5</u> (HP) (yield gpm)			
<u>elec</u> (type power)			
(7) electric log <u>no</u> (yes or no)			
(organization running log)			
(8) how well bottom plugged <u>BP White</u>			

**CODED**


SEP 11 1970

DRILLERS REMARKS:

MISS. BD. OF  
WATER COMM.

If well telescopes please sketch and show depths.

GROUND LEVEL

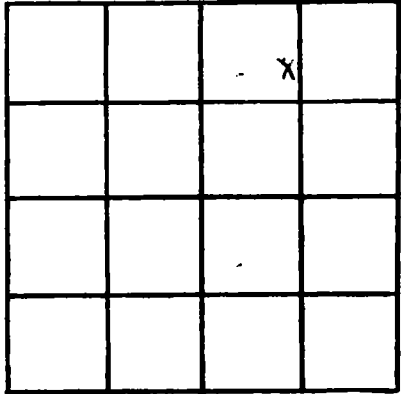

SECTION 18

Please indicate well location X.

ADDITIONAL INFORMATION

Lined area for additional information.

If more than one screen, show locations of each on sketch.