

JACKSON  
F 53  
8-18-70

MISSISSIPPI  
BOARD OF WATER COMMISSIONERS  
416 North State Street  
Jackson, Mississippi 39201

**CODED**

WATER WELL DRILLERS LOG

August 18 1970 Cabilla Water Supply Jackson  
date well completed firm name county well located

LANDOWNER: <u>E. V. Suthoff</u>	description of formations encountered	from	to
<u>Van Cleave Miss</u> (mailing address)	<u>clay</u>	<u>0</u>	<u>10</u>
WELL LOCATION: sec. <u>29</u> T <u>5</u> N R. <u>7</u> E <u>5</u> miles <u>NE</u> of <u>Van Cleave</u> (distance) (direction) (nearest town)	<u>reddish clay</u>	<u>10</u>	<u>27</u>
WELL PURPOSE: <u>home</u> (home, irrigation, municipal, industrial)	<u>fine sand</u>	<u>27</u>	<u>58</u>
WELL COMPLETION DATA: (1) diameter (inches) <u>2</u>	<u>clay</u>	<u>58</u>	<u>209</u>
(2) total depth (feet) <u>223</u>	<u>sand</u>	<u>209</u>	<u>223</u>
(3) static water level (feet) <u>80</u> <u>below</u> above top of ground.			
(4) casing <u>galv</u> , <u>218</u> (material) (depth)			
(5) screen <u>5'</u> , <u>218</u> (length) (depth to top)			
<u>2"</u> , <u>stainless</u> (size) (material)			
(6) pump _____ (HP) (yield gpm)			
(7) electric log <u>no</u> (yes or no)			
(8) how well bottom plugged <u>BP Vahel</u>			
DRILLERS REMARKS: <u> pump installed by owner</u>			


**CODED**

SEP 11 1970

MISS. BD. OF  
WATER COM.

If well telescopes please sketch and show depths.

GROUND LEVEL

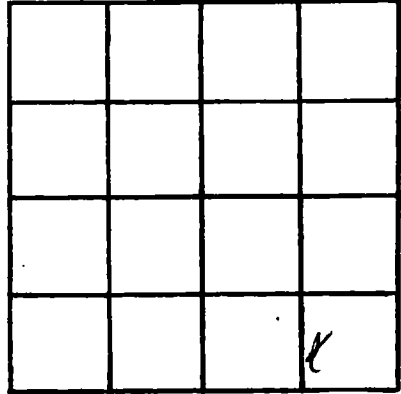

SECTION 29

Please indicate well location X.

ADDITIONAL INFORMATION

If more than one screen, show locations of each on sketch.