

JACKSON  
F 54  
11-5-70

MISSISSIPPI  
BOARD OF WATER COMMISSIONERS  
416 North State Street  
Jackson, Mississippi 39201

**CODED**

WATER WELL DRILLERS LOG

Nov 5 1970 Colette Water Supply Jackson  
date well completed firm name county well located

LANDOWNER: Bell  
Swift  
Vanhook Miss  
(mailing address)

WELL LOCATION:  
sec. 34 T 5 N R 7 E  
6 miles NW of Vanhook  
(distance) (direction) (nearest town)

WELL PURPOSE: home  
(home, irrigation, municipal, industrial)

WELL COMPLETION DATA:

(1) diameter (inches) 4 X 2

(2) total depth (feet) 688

(3) static water level (feet) 82.4' <sup>below</sup> above  
top of ground.

(4) casing Galv. 673  
(material) (depth)

20 If telescope see back.  
(size)

(5) screen 15' 673  
(length) (depth to top)

2" astarline  
(size) (material)

(6) pump 1 30  
(HP) (yield gpm)

Elec  
(type power)

(7) electric log no  
(yes or no)

(organization running log)

(8) how well bottom plugged BP Valve

description of formations encountered	from	to
<u>sandy clay</u>	<u>0</u>	<u>22</u>
<u>sand</u>	<u>22</u>	<u>40</u>
<u>clay</u>	<u>40</u>	<u>100</u>
<u>sand</u>	<u>100</u>	<u>124</u>
<u>clay</u>	<u>124</u>	<u>198</u>
<u>sand</u>	<u>198</u>	<u>208</u>
<u>clay</u>	<u>208</u>	<u>247</u>
<u>sand</u>	<u>247</u>	<u>258</u>
<u>clay</u>	<u>258</u>	<u>435</u>
<u>fine sand</u>	<u>435</u>	<u>449</u>
<u>clay</u>	<u>449</u>	<u>474</u>
<u>strata of fine sand and clay</u>	<u>474</u>	<u>564</u>
<u>sand</u>	<u>564</u>	<u>569</u>
<u>clay</u>	<u>569</u>	<u>674</u>
<u>sand</u>	<u>674</u>	<u>688</u>

**CODED**



JAN 25 1971

MISS. BD. OF  
WATER COMM.

DRILLERS REMARKS:

If well telescopes please sketch and show depths.

GROUND LEVEL

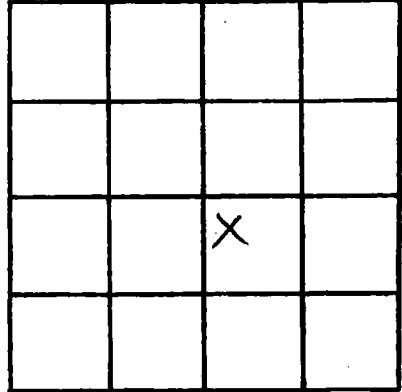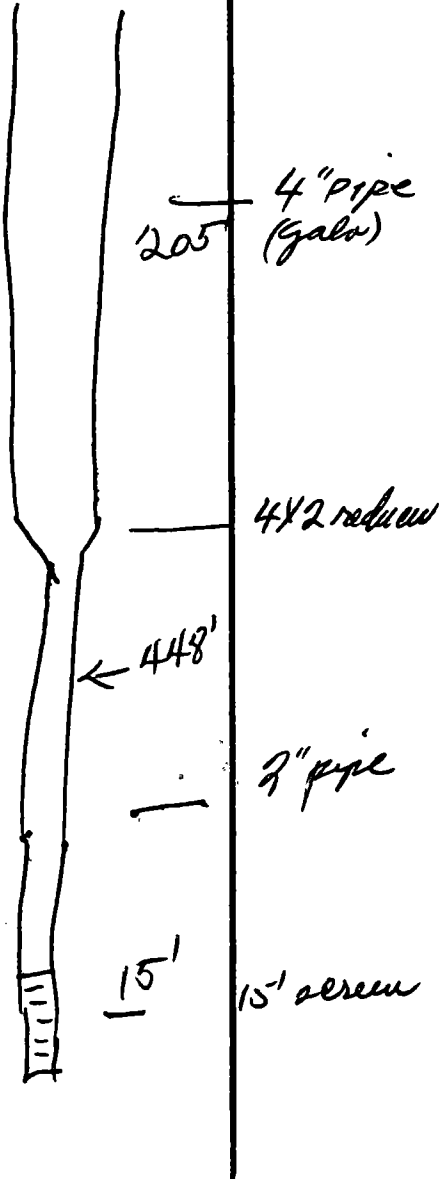

SECTION 3A

Please indicate well location X.

ADDITIONAL INFORMATION

Lined area for additional information.

If more than one screen, show locations of each on sketch.