

Jackson
F-63
9-14-71

MISSISSIPPI
BOARD OF WATER COMMISSIONERS
416 North State Street
Jackson, Mississippi 39201

CODED

WATER WELL DRILLERS LOG

9-14 1971 Coast Water Well Serv. Jackson
date well completed firm name county well located

LANDOWNER: Oscar Hill

description of formations encountered from to

Lake-O-Jenia

top soil 0 10

Vanclave Miss
(mailing address)

red clay 10 30

WELL LOCATION:

sec. 32 T. 5 S. R. 7 E.
3 miles N of Vanclave
(distance) (direction) (nearest town)

Sand fine - coarse 30 50

blue clay 50 100

Sand fine - coarse 100 135

WELL PURPOSE: Comp
(home, irrigation, municipal, industrial)

blue clay 135 231

WELL COMPLETION DATA:

sand - coarse 231 262

(1) diameter (inches) 2"

(2) total depth (feet) 262

(3) static water level (feet) 55 below top of ground

(4) casing PVC 252
(material) (depth)

2" If telescope see back.
(size)

(5) screen 10' 252'
(length) (depth to top)

2" Stainless basket
(size) (material)

(6) pump 1 10
(HP) (yield gpm)

elec.
(type power)

(7) electric log no.
(yes or no)

(organization running log)

(8) how well bottom plugged
backwash valve

DRILLERS REMARKS:


CODED

SEP 20 1971

MISS. BD. OF
WATER COMM.

If well telescopes please sketch and show depths.

GROUND LEVEL

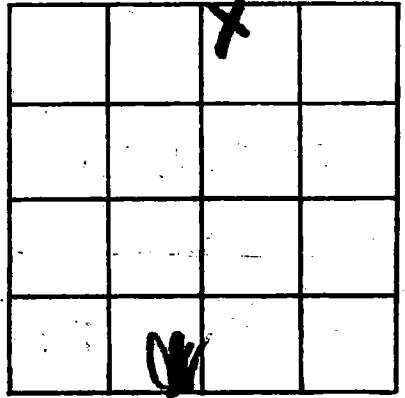

SECTION 32

Please indicate well location X.

ADDITIONAL INFORMATION

If more than one screen, show locations of each on sketch.