

Jackson  
 F 73  
 7-31-73

MISSISSIPPI  
 BOARD OF WATER COMMISSIONERS  
 416 North State Street  
 Jackson, Mississippi 39201

**CODED**

WATER WELL DRILLERS LOG

7/31 1973 COAST WATER WELL SERVICE Jackson  
 date well completed firm name county well located

LANDOWNER: George Truitt  
Rt. 2 Box 98  
Ocean Springs, Mo. 39564  
 (mailing address)

description of formations encountered	from	to
<u>Top soil</u>	<u>0</u>	<u>21</u>
<u>Blue clay</u>	<u>21</u>	<u>84</u>
<u>fine to med. sand</u>	<u>84</u>	<u>107</u>
<u>Blue clay</u>	<u>107</u>	<u>215</u>
<u>Med. to coarse sand</u>	<u>215</u>	<u>262</u>

WELL LOCATION:  
 sec. 29T 5 R. 7E  
3 1/2 miles N of Meridian  
 (distance) (direction) (nearest town)

WELL PURPOSE: Home  
 (home, irrigation, municipal, industrial)

WELL COMPLETION DATA:

- (1) diameter (inches) 2"
- (2) total depth (feet) 262'
- (3) static water level (feet) 62 below top of ground.
- (4) casing P.V.C., 252'  
 (material) (depth)  
2" If telescope see back.  
 (size)
- (5) screen 10', 252'  
 (length) (depth to top)  
2", P.V.C.  
 (size) (material)
- (6) pump 1 9  
 (HP) (yield gpm)  
elec.  
 (type power)
- (7) electric log NO  
 (yes or no)
- (organization running log)
- (8) how well bottom plugged backwash blue

**CODED**


SEP 21 1973

DRILLERS REMARKS:

MISS. DIV. OF  
 WATER CONTROL

If well telescopes please  
sketch and show depths.

GROUND LEVEL

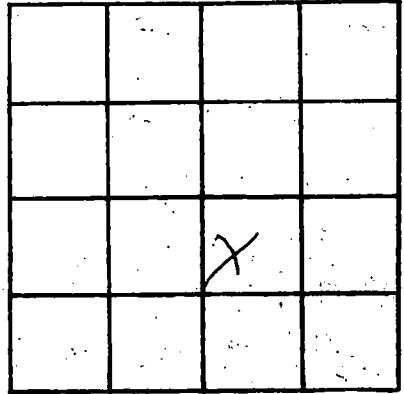

SECTION 29

Please indicate well location X.

ADDITIONAL INFORMATION

If more than one screen,  
show locations of each on sketch.