

JACKSON
F 74
9-29-73

MISSISSIPPI
 BOARD OF WATER COMMISSIONERS
 416 North State Street
 Jackson, Mississippi 39201 **CODED**

WATER WELL DRILLERS LOG

September 29, 1973 GARLAND WATER WELLS JACKSON
 date well completed firm name county well located

LANDOWNER: PAUL G CARTER

Rt 2, Box 170

VAN CLEAVE, Miss
 (mailing address)

WELL LOCATION:

sec. 35 T. 5 N. R. 7 E
4 miles North of VAN CLEAVE
 (distance) (direction) (nearest town)

WELL PURPOSE: Home
 (home, irrigation, municipal, industrial)

WELL COMPLETION DATA:

- (1) diameter (inches) 2"
- (2) total depth (feet) 326'
- (3) static water level (feet) 60' below above top of ground.
- (4) casing GALVANIZE PIPE 316'
 (material) (depth)
2"
 (size) if telescope see back.
- (5) screen 10', 326' to 316'
 (length) (depth to top)
2, STAINLESS STEEL
 (size) (material)
- (6) pump 1 10-12
 (HP) (yield gpm)
ELECTRIC
 (type power)
- (7) electric log No
 (yes or no)
N/A
 (organization running log)
- (8) how well bottom plugged BRASS
BACK WASH VALVE

description of formations encountered

from to

<u>Top Soil</u>	<u>0</u>	<u>10</u>
<u>YELLOW Clay</u>	<u>10</u>	<u>35</u>
<u>FINE SAND</u>	<u>35</u>	<u>50</u>
<u>BLUE CLAY</u>	<u>50</u>	<u>90</u>
<u>COURSE SAND</u>	<u>90</u>	<u>130</u>
<u>BLUE CLAY</u>	<u>130</u>	<u>200</u>
<u>FINE SAND</u>	<u>200</u>	<u>220</u>
<u>BLUE CLAY</u>	<u>220</u>	<u>280</u>
<u>MED-SAND</u>	<u>280</u>	<u>300</u>
<u>COURSE SAND</u>	<u>300</u>	<u>325</u>


DRILLERS REMARKS:

DEC - 6 1973

MISSISSIPPI
 WATER COMMISSION

If well telescopes please sketch and show depths.

GROUND LEVEL

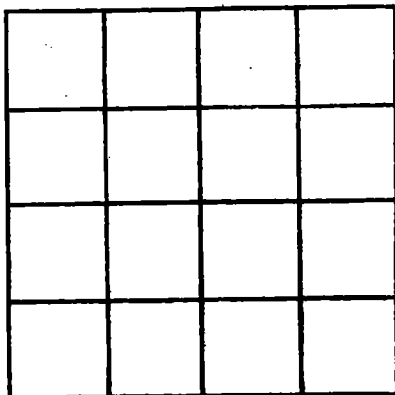

SECTION _____

Please indicate well location X.

ADDITIONAL INFORMATION

If more than one screen, show locations of each on sketch.