

JACKSON
F-75
12-6-73

MISSISSIPPI
BOARD OF WATER COMMISSIONERS
416 North State Street
Jackson, Mississippi 39201

CODED

WATER WELL DRILLERS LOG

Dec 6 1973 LaBelle Water Supply Jackson
date well completed firm name county well located

LANDOWNER: Red Hill Church
Vanleave Mrs.
(mailing address)

description of formations encountered	from	to
<u>Sandy clay</u>	<u>0</u>	<u>22</u>
<u>shud</u>	<u>22</u>	<u>88</u>
<u>clay</u>	<u>88</u>	<u>190</u>
<u>Soaked</u>	<u>190</u>	<u>216</u>

WELL LOCATION:
sec. 2 T. 5 N R. 7 E
8 miles North of Vanleave
(distance) (direction) (nearest town)

WELL PURPOSE: Church
(home, irrigation, municipal, industrial)

CODED


- WELL COMPLETION DATA:
- (1) diameter (inches) 2
 - (2) total depth (feet) 216
 - (3) static water level (feet) 126 ^{below} ~~above~~ top of ground.
 - (4) casing galv 210
(material) (depth)
(size) If telescope see back.
 - (5) screen 6 210
(length) (depth to top)
2 stainl
(size) (material)
 - (6) pump 2 6
(HP) (yield gpm)
elec
(type power)
 - (7) electric log no
(yes or no).
(organization running log)
 - (8) how well bottom plugged BP valve

DEC 21 1973

DRILLERS REMARKS:

If well telescopes please sketch and show depths.

GROUND LEVEL

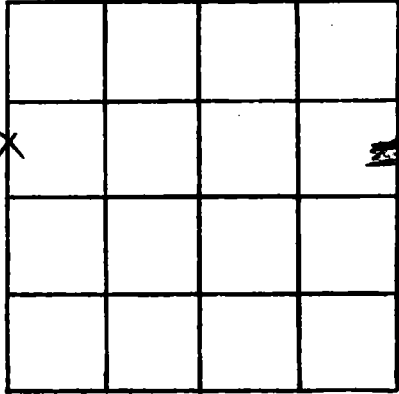

SECTION 2

Please indicate well location X.

ADDITIONAL INFORMATION

If more than one screen, show locations of each on sketch.