

JACKSON
F76
10-18-73

MISSISSIPPI
BOARD OF WATER COMMISSIONERS **CODED**
416 North State Street
Jackson, Mississippi 39201

WATER WELL DRILLERS LOG

Oct 18 1973 Catalytic Water Supply Jackson
date well completed firm name county well located

LANDOWNER: <u>Kenneth Keener</u>	description of formations encountered	from	to
<u>Keener</u> <u>1400 W. W. Ave. M.S.</u> (mailing address)	<u>Clay</u>	<u>0</u>	<u>15</u>
	<u>Sand</u>	<u>15</u>	<u>45</u>
	<u>Clay</u>	<u>45</u>	<u>216</u>
	<u>Sand</u>	<u>216</u>	<u>233</u>
	<u>Clay</u>	<u>233</u>	<u>390</u>
	<u>Sand</u>	<u>390</u>	<u>431</u>
WELL LOCATION: sec. <u>30</u> T <u>5</u> N R <u>7</u> E <u>4</u> miles <u>NW</u> of <u>Wadsworth</u> (distance) (direction) (nearest town)			
WELL PURPOSE: <u>Home</u> (home, irrigation, municipal, industrial)			
WELL COMPLETION DATA:			
(1) diameter (inches) <u>2</u>			
(2) total depth (feet) _____			
(3) static water level (feet) _____ below above top of ground.			
(4) casing <u>Galv</u> (material) (depth) _____			
_____ (size) if telescope see back.			
(5) screen <u>5</u> (length) (depth to top) _____			
<u>2"</u> (size) <u>stainless</u> (material)			
(6) pump <u>1 1/2</u> <u>15</u> (HP) (yield gpm)			
<u>elec</u> (type power)			
(7) electric log <u>no</u> (yes or no)			
_____ (organization running log)			
(8) how well bottom plugged <u>B.P. Well</u>			
DRILLERS REMARKS:			


CODED

DEC 21 1973

MISSISSIPPI WATER COMM.

If well telescopes please sketch and show depths.

GROUND LEVEL

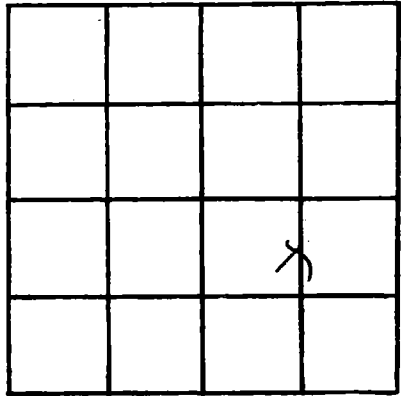

SECTION 35

Please indicate well location X.

ADDITIONAL INFORMATION

If more than one screen, show locations of each on sketch.