

MISSISSIPPI
BOARD OF WATER COMMISSIONERS
416 North State Street
Jackson, Mississippi 39201

CODED

WATER WELL DRILLERS LOG

COAST WATER WELL SERVICE

Jackson
County well located

1/28 1974
date well completed

firm name

LANDOWNER: Robert B. Beard

description of formations encountered

from to

2926 Market St.

top soil

0 21

Passagoula Miss.
(mailing address)

coarse sand

21 42

WELL LOCATION:

sand + clay

42 63

sec. 38 T. 5 S. R. 7 W.
4 1/2 miles NE of Doncha
(distance) (direction) (nearest town)

clay

63 147

WELL PURPOSE: home
(home, irrigation, municipal, industrial)

sand + clay

147 169

WELL COMPLETION DATA:

med sand + clay

169 189

(1) diameter (inches) 2"

coarse sand

189 210

(2) total depth (feet) 205'

CODED

(3) static water level (feet) 105 below top of ground.

(4) casing PVC, 195'
(material) (depth)

2" if telescope see back.
(size)

(5) screen 10', 195'
(length) (depth to top)

2", PVC
(size) (material)

(6) pump 10
(HP) (yield gpm)

air
(type power)

(7) electric log NO
(yes or no)

(organization running log)

(8) how well bottom plugged

B.W. Value

RECEIVED


JUL 12 1974

DRILLERS REMARKS:

MISS. BD. OF WATER COMM

If well telescopes please sketch and show depths.

GROUND LEVEL

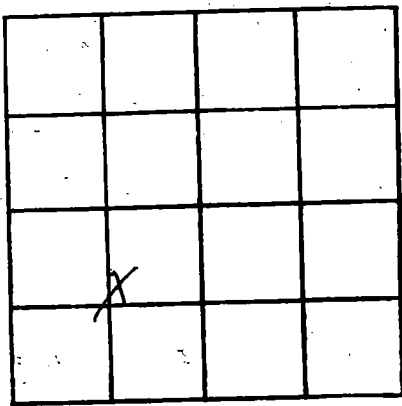

SECTION 38

Please indicate well location X.

ADDITIONAL INFORMATION

If more than one screen, show locations of each on sketch.