

JACKSON
F 86
9-20-74

MISSISSIPPI
 BOARD OF WATER COMMISSIONERS
 416 North State Street
 Jackson, Mississippi 39201

CODED

WATER WELL DRILLERS LOG

9/20 1974 date well completed
 COAST WATER WELL SERVICE firm name
 Jackson county well located

LANDOWNER: D. H. Shepherd
Labu-o-Louis
Vanhook, Mo.
 (mailing address)

description of formations encountered	from	to
Top soil	0	4
Red clay	4	15
Sand F.	15	21
Grey clay	21	35
Sand - C	35	100
Blue clay	100	235
Sand - C	235	285

WELL LOCATION:

sec. 28 T 5 S R. 7 W
3 miles N of Vanhook
 (distance) (direction) (nearest town)

WELL PURPOSE: Home
 (home, irrigation, municipal, industrial)

WELL COMPLETION DATA:

- (1) diameter (inches) 2"
- (2) total depth (feet) 285'
- (3) static water level (feet) 85 below top of ground
- (4) casing PVC, 275'
 (material) (depth)
- 2" if telescope see back.
 (size)
- (5) screen 10', 275'
 (length) (depth to top)
- 2", PVC
 (size) (material)
- (6) pump 2 8
 (HP) (yield gpm)
- elec.
 (type power)
- (7) electric log NO
 (yes or no)

(organization running log)


(8) how well bottom plugged
B. 26 1/2"

DRILLERS REMARKS:

RECEIVED
 MAY 16 1975

If well telescopes please sketch and show depths.

GROUND LEVEL

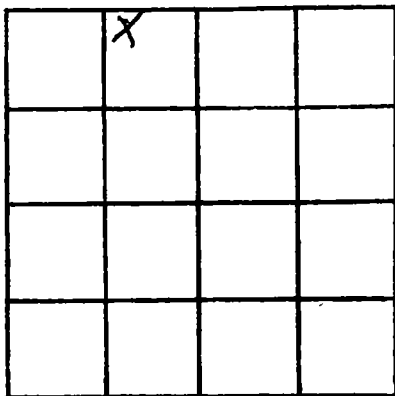

SECTION 28

Please indicate well location X.

ADDITIONAL INFORMATION

If more than one screen,
show locations of each on sketch.