

Jackson
F 87
4-15-74

MISSISSIPPI
BOARD OF WATER COMMISSIONERS
416 North State Street
Jackson, Mississippi 39201

CODED

WATER WELL DRILLERS LOG

4/15 1974 COASTAL DRILLING & SERVICE CO. Jackson
date well completed firm name county well located

LANDOWNER	description of formations encountered	from	to
Dib Smith Biloxi, Miss.	Top Soil	3	3
	Red Clay	3	15
	White Sand	15	30
	Shale	30	25
	fine water sand	25	90
	hard blue clay	90	160
	fine water sand	160	180
	hard blue clay	180	240
	fine water sand	240	260
	blue water sand	260	298'


WELL LOCATION:
sec 18 T. 5 N R. 7 E 13 Q
S W
1/4 miles NW Vancleave
(distance) (direction) (nearest town)

WELL PURPOSE: Home
(home, irrigation, municipal, industrial)

- WELL COMPLETION DATA:
- (1) diameter (inches) 2"
 - (2) total depth (feet) 298'
 - (3) static water level (feet) 80 below top of ground.
 - (4) casing 2" PVC 298' (material) (depth)
 - (5) screen 10' 298' (length) (depth to top)
2" PVC (size) (material)
 - (6) pump 1 1/2 (HP) 10 (yield gpm)
Ele (type power)
 - (7) electric log no (yes or no)
 - (organization running log)

(8) how well bottom plugged
2" brush with chisel


DRILLERS REMARKS:

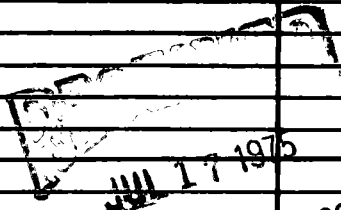

MISS. BD. OF WATER COMM

If well telescopes please sketch and show depths.

GROUND LEVEL

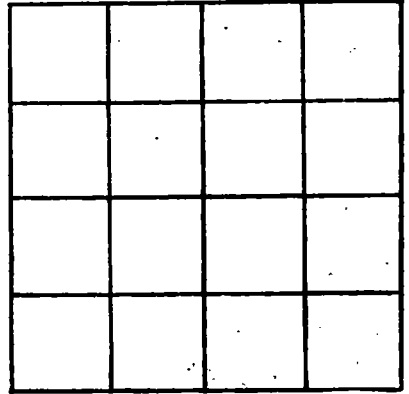

SECTION _____

Please indicate well location X.

ADDITIONAL INFORMATION

If more than one screen, show locations of each on sketch.