

JACKSON
F 88
9/23/77

MISSISSIPPI
BOARD OF WATER COMMISSIONERS
416 North State Street
Jackson, Mississippi 39201

CODED

WATER WELL DRILLERS LOG

9-23 date well completed 1977 Coast Water Well Serv. firm name Jackson county well located

LANDOWNER: Jim Guy
2219 West Jordan
Penacola, Fla. 32505
(mailing address)

description of formations encountered	from	to
Top soil	0	21
Sand Gravel	21	45
Blue Clay	45	228
Sand (mc)	228	243

WELL LOCATION:
sec 38 T X R 7
6 miles S of West Jordan
(distance) (direction) (nearest town)

WELL PURPOSE: home
(home, irrigation, municipal, industrial)

WELL COMPLETION DATA:

(1) diameter (inches) 2"

(2) total depth (feet) 243'

(3) static water level (feet) flow below top of ground.

(4) casing PVC, 233'
(material) (depth)

2" if telescope see back.
(size)

(5) screen 10', 233'
(length) (depth to top)

2", PVC
(size) (material)

(6) pump None, 30
(HP) (yield gpm)

(type power)

(7) electric log No.
(yes or no)

(organization running log)

(8) how well bottom plugged
Backwash Valve

DRILLERS REMARKS:


RECEIVED

JAN 16 1978

MISS. BD. OF WATER COMM

If well telescopes please sketch and show depths.

GROUND LEVEL

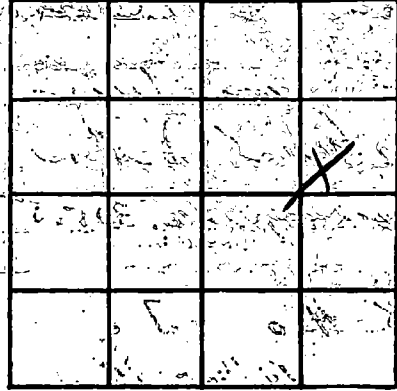

SECTION 38

Please indicate well location X.

ADDITIONAL INFORMATION

If more than one screen, show locations of each on sketch.