

MISSISSIPPI DEPARTMENT OF NATURAL RESOURCES  
 Bureau of Land and Water Resources  
 Southport Mall  
 P.O. Box 10631  
 Jackson, Mississippi 39209  
**WATER WELL DRILLERS LOG**

CODED

JACKSON  
 F 90

7-16-86 19 Coast water well Jackson  
 date well completed firm name county well located

LANDOWNER: Ernest Smith  
 2204 Summerlin Bayou Rd  
 Vancleave, Ms. 39564  
 (milling address)

WELL LOCATION:  
 sec 23 T 5 N R 7 E  
 S W  
 5 miles NE of VANCELEAVE  
 (distance) (direction) (nearest town)

WELL PURPOSE: home  
 (home, irrigation, municipal, industrial)

WELL COMPLETION DATA:

- (1) diameter (Inches) 2"
- (2) total depth (feet) 257
- (3) static water level (feet) 93 below top of ground.
- (4) casing PVC, 242' (material), (depth)  
 2" (size) If telescope see back.
- (5) screen 10' (length), 242' (depth to top)  
 2" (size), PVC (material)
- (6) pump 2 (HP), 70 (yield gpm)  
 Elect (type power)
- (7) electric log NO (yes or no)  
 (organization running log)
- (8) how well bottom plugged backwash valve.

description of formations encountered	from	to
Top Soil	0	3
Red Clay	3	15
Red Med Sand	15	23
Red Coarse Sand + Gravel	23	53
Blue Clay	53	225
Gray Coarse Sand	225	252
Gray Fine Sand	252	257

RECEIVED


AUG 27 1986

Department of Natural Resources  
 Bureau of Land & Water Resources

DRILLERS REMARKS:  
 5'-2" PVC tail pipe.

If well telescopes please sketch and show depths.

GROUND LEVEL

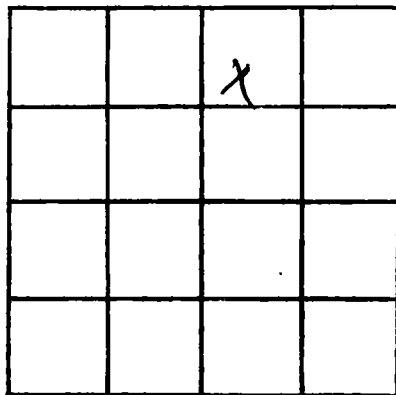

SECTION 23

Please indicate well location X.

**ADDITIONAL INFORMATION**

If more than one screen, show locations of each on sketch.