

**MISSISSIPPI DEPARTMENT OF ENVIRONMENTAL QUALITY**

Office of Land and Water Resources

P. O. Box 10631  
Jackson, MS 39289-0631  
**WATER WELL DRILLERS LOG**

COUNTY WELL LOCATED <b>JACKSON</b>	
WELL NUMBER <b>F 94</b>	CODED <input checked="" type="checkbox"/>
DATE WELL COMPLETED <b>11-18-92</b>	

PERMIT NUMBER
NAME OF DRILLING FIRM <b>Coast Water Well</b>

NAME & MAILING ADDRESS OF LANDOWNER <b>Robert Gilbert</b>			
WELL LOCATION	SEC	TOWNSHIP	RANGE
	<b>26</b>	<b>5</b>	<b>7</b>
		<b>(S)</b>	<b>(W)</b>
DISTANCE	DIRECTION	NEAREST TOWN	
<b>4</b> Miles	<b>NE</b>	of <b>Unchou</b>	
OTHER LANDMARK			
WELL PURPOSE <input checked="" type="checkbox"/> Home Irrigation, <input type="checkbox"/> Municipal, <input type="checkbox"/> Industrial, <input type="checkbox"/> Fish Pond, etc.			

PUMP DATA		
PUMP TYPE (Circle One): Submersible, Turbine, <input checked="" type="checkbox"/> Jet, Flowing Well, Other (Describe) _____		
POWER TYPE (Circle One): <input checked="" type="checkbox"/> Electric, Tractor, Diesel, Gasoline, Butane, Other (Describe) <b>H/P 2</b>		
Pump Capacity (GPM) <b>6</b>	No. of Stages <b>3</b>	Setting Depth _____ FT.
PUMP TEST		
Well yielded _____ GPM with a drawdown of _____ ft. after _____ hours of pumping		

WELL DATA		
Well Depth <b>270</b>	Casing Diameter (In.) <b>2"</b>	Casing Length (Ft.) <b>260</b>
Type of Casing <b>PUC</b>	Hole Depth <b>275</b>	Depth to Static Water Level <b>105</b>

LOG DATA	
TYPE OF LOG RUN (Circle One): <input checked="" type="checkbox"/> No Log Run, Electric, Gamma Ray, Density, Sonic, Neutron, Other (Describe) _____	
Name of Organization Running Log	

TYPE OF COMPLETION: (Circle One or More): <input checked="" type="checkbox"/> Gravel Packed, <input type="checkbox"/> Underreamed, <input type="checkbox"/> Telescoped, <input type="checkbox"/> Natural Development, <input type="checkbox"/> Open Hole, <input type="checkbox"/> Other (Describe) _____	
WELL GROUTED TO A DEPTH OF <b>10</b> FEET Type Grout (circle one): Cement, Bentonite, or Mix	

GEOLOGIC DATA (Office Use Only)			
Surface Elev.	Geologic Unit	Unit Thickness	Depth to Top
Subs. SWL	Date	Analysis	Aquifer Test

SCREEN DATA		
Diameter - Inches <b>2"</b>	Length - Feet <b>10</b>	Slot Size - Inches <b>8</b>
Screen Type <b>PUC</b>		Depth to Bottom - Feet <b>270</b>

Driller's Remarks


DESCRIPTION OF FORMATIONS ENCOUNTERED	FROM	TO
<b>top soil</b>	<b>0</b>	<b>2</b>
<b>Red Clay</b>	<b>2</b>	<b>20</b>
<b>Med sand</b>	<b>20</b>	<b>50</b>
<b>Blue Clay</b>	<b>50</b>	<b>100</b>
<b>Med sand</b>	<b>100</b>	<b>115</b>
<b>Blue Clay</b>	<b>115</b>	<b>250</b>
<b>Med sand</b>	<b>250</b>	<b>270</b>
<b>Blue Clay</b>	<b>270</b>	<b>275</b>

FORMATIONS (Continued)	FROM	TO
<b>RECEIVED</b>		
<b>JAN 27 1993</b>		
Dept. of Environmental Quality Office of Land and Water Resources		

IF MORE SPACE IS NEEDED, USE BACK

If well telescopes please sketch and show depths.

GROUND LEVEL

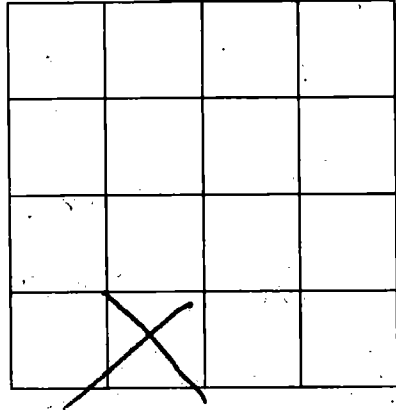

SECTION \_\_\_\_\_

Please indicate well location X.

ADDITIONAL INFORMATION

Lined area for additional information.

If more than one screen, show location of each on sketch.