

**MISSISSIPPI DEPARTMENT OF ENVIRONMENTAL QUALITY**  
Bureau of Land and Water Resources

P. O. Box 10631  
Jackson, MS 39289-0631  
**WATER WELL DRILLERS LOG**

COUNTY WELL LOCATED <i>Jackson</i>	
WELL NUMBER <i>2796</i>	CODED <input checked="" type="checkbox"/>
DATE WELL COMPLETED <i>10-19-92</i>	

PERMIT NUMBER
NAME OF DRILLING FIRM <i>Coast Water Wells, Inc.</i>

NAME & MAILING ADDRESS OF LANDOWNER <i>Robert Galary</i>		
WELL LOCATION: SEC <i>28</i> TOWNSHIP <i>5 N</i> RANGE <i>7 E</i>		
DISTANCE <i>3</i> Miles	DIRECTION <i>N</i>	NEAREST TOWN <i>Harshave</i>
OTHER LANDMARK		
WELL PURPOSE: <input checked="" type="checkbox"/> Home Irrigation, <input type="checkbox"/> Municipal, <input type="checkbox"/> Industrial, <input type="checkbox"/> Fish Pond, etc.		

<b>PUMP DATA</b>		
PUMP TYPE (Circle One): Submersible, Turbine, <input checked="" type="radio"/> Jet, Flowing Well, Other (Describe) _____		
POWER TYPE (Circle One): <input checked="" type="radio"/> Electric, Tractor, Diesel, Gasoline, Butane, Other (Describe) _____ H/P <i>1</i>		
Pump Capacity (GPM) <i>6</i>	No. of Stages <i>2</i>	Setting Depth _____ FT.
PUMP TEST Well yielded _____ GPM with a drawdown of _____ ft. after _____ hours of pumping		

<b>WELL DATA</b>		
Well Depth <i>250'</i>	Casing Diameter (In.) <i>2"</i>	Casing Length (Ft.) <i>240'</i>
Type of Casing <i>PVC</i>	Hole Depth <i>250'</i>	Depth to Static Water Level <i>68'</i>
TYPE OF COMPLETION: (Circle One or More): <input checked="" type="checkbox"/> Gravel Packed, <input type="checkbox"/> Underreamed, <input type="checkbox"/> Telescoped, <input type="checkbox"/> Natural Development, <input type="checkbox"/> Open Hole, <input type="checkbox"/> Other (Describe) _____		
Top of Lap Pipe or Reduction in Casing _____ FEET IF TELESCOPED OR MORE THAN ONE SCREEN: USE BACK PAGE		

<b>LOG DATA</b>	
TYPE OF LOG RUN (Circle One): Electric, Gamma Ray, Density, Sonic, Neutron, Other (Describe) _____ <input checked="" type="radio"/> No Log Run	
Name of Organization Running Log	

<b>SCREEN DATA</b>		
Diameter - Inches <i>2"</i>	Length - Feet <i>10'</i>	Slot Size - Inches <i>.008</i>
Screen Type <i>PVC</i>	Depth to Bottom - Feet <i>250'</i>	

<b>GEOLOGIC DATA (Office Use Only)</b>			
Surface Elev.	Geologic Unit	Unit Thickness	Depth to Top
Subs. SWL	Date	Analysis	Aquifer Test


Driller's Remarks

DESCRIPTION OF FORMATIONS ENCOUNTERED	FROM	TO	FORMATIONS (Continued)	FROM	TO
<i>top soil</i>	<i>0</i>	<i>2</i>	<b>RECEIVED</b>  JAN 27 1993  Dept. of Environmental Quality Office of Land & Water Resources		
<i>gray/pink clay</i>	<i>2</i>	<i>25</i>			
<i>light coarse sand</i>	<i>25</i>	<i>80</i>			
<i>blue clay 5' of sand</i>	<i>80</i>	<i>220</i>			
<i>coarse sand</i>	<i>220</i>	<i>250</i>			

IF MORE SPACE IS NEEDED, USE BACK

If well telescopes please sketch and show depths.

GROUND LEVEL

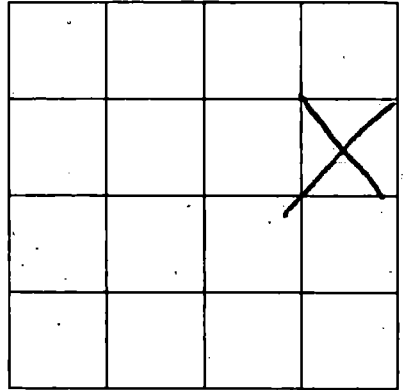

SECTION \_\_\_\_\_

Please indicate well location X.

ADDITIONAL INFORMATION

DRIVER

If more than one screen, show location of each on sketch.