

COUNTY WELL LOCATED
Jackson

WELL NUMBER **F135** CODE

DATE WELL COMPLETED
4-8-97

PERMIT NUMBER

NAME OF DRILLING FIRM
Coast Water Well Service

MISSISSIPPI DEPARTMENT OF ENVIRONMENTAL QUALITY
Office of Land and Water Resources

P. O. Box 10631
 Jackson, MS 39289-0631
WATER WELL DRILLERS LOG

NAME & MAILING ADDRESS OF LANDOWNER
Matthew Hill
Old River Rd.
Vandover, Ms

WELL LOCATION SEC **11** TOWNSHIP **5** RANGE **7E**

DISTANCE **6 1/2** Miles DIRECTION **North** of NEAREST TOWN **Vandover**

OTHER LANDMARK

WELL PURPOSE Home Irrigation, Municipal, Industrial, Fish Pond, etc.

PUMP DATA

PUMP TYPE (Circle One): Submersible, Turbine, **Flowing Well**, Other (Describe) _____

POWER TYPE (Circle One): **Electric**, Tractor, Diesel, Gasoline, Butane, Other (Describe) _____ H/P **1**

Pump Capacity (GPM) **5** No. of Stages **2** Setting Depth _____ FT.

PUMP TEST

Well yielded _____ GPM with a drawdown of _____ ft. after _____ hours of pumping

WELL DATA

Well Depth 117'	Casing Diameter (In.) 2"	Casing Length (Ft.) 109'
Type of Casing PVC	Hole Depth 117'	Depth to Static Water Level 85'

LOG DATA

TYPE OF LOG RUN (Circle One): **No Log Run**, Electric, Gamma Ray, Density, Sonic, Neutron, Other (Describe) _____

Name of Organization Running Log _____

TYPE OF COMPLETION: (Circle One or More): Gravel Packed, Underreamed, Telescoped, Natural Development, Open Hole, Other (Describe) _____

WELL GROUTED TO A DEPTH OF **20** FEET
 Type Grout (circle one): Cement, Bentonite, or Mix

GEOLOGIC DATA (Office Use Only)

Surface Elev.	Geologic Unit	Unit Thickness	Depth to Top
Subs. SWL	Date	Analysis	Aquifer Test

Driller's Remarks

Top of Lap Pipe or Reduction in Casing

FEET IF TELESCOPED OR MORE THAN ONE SCREEN: USE BACK PAGE

SCREEN DATA

Diameter - Inches 2"	Length - Feet 10'	Slot Size - Inches .008
Screen Type PVC	Depth to Bottom - Feet 117'	

DESCRIPTION OF FORMATIONS ENCOUNTERED	FROM	TO	FORMATIONS (Continued)	FROM	TO
Top Soil	0	2			
White Coarse sand	2	40			
Blue Clay	40	95			
White Coarse sand	95	117			


JUL 21 1997

Dept. of Environmental Quality
 Office of Land & Water Resources

IF MORE SPACE IS NEEDED, USE BACK

If well telescopes please sketch and show depths.

GROUND LEVEL

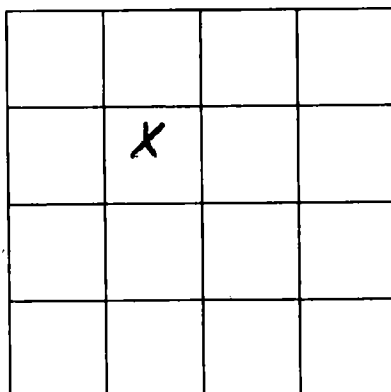

SECTION 11

Please indicate well location X.

ADDITIONAL INFORMATION

If more than one screen, show location of each on sketch.